

REDLINE SUMMARY - TXCA0977 CD REV 1

ScopelQ - 2026-10-07 - 2 markup(s) - status per ScopelQ workflow

#	SHEET	MARKUP	FROM	TO	STATUS
1	A-3	ADD MOUNT REINFORCEMENT PER MA-TXCA0977-R0: ALPHA MRK x1. ADD TO T-1 SCOPE OF WORK.	not shown	ALPHA MRK x1	DRAFT
2	A-4	REVISE CABLE SCHEDULE HORIZ RUN 45 FT -> 18 FT (MEASURED). RECOMPUTE REQ'D LENGTH AND SPECIFIED TRUNK.	45 ft	18 ft	DRAFT

CARRIER-A - 5G C-BAND ADD

TXCA0977 CARROLLTON STATION

SCOPE OF WORK

- 1. INSTALL (3) AIR 6449 B77D
- 2. INSTALL (1) BASEBAND 6648 IN EXISTING CABINET
- 3. INSTALL (1) HYBRID TRUNK 6x12, 200 FT, WITH TOP AND BASE OVP
- 4. FIELD VERIFY ALL EXISTING CONDITIONS PRIOR TO CONSTRUCTION

SHEET INDEX

- T-1 TITLE SHEET & SCOPE OF WORK
- A-2 ELEVATION
- A-3 ANTENNA LAYOUT PLAN
- A-4 ANTENNA & CABLE SCHEDULE
- E-1 GROUNDING PLAN & NOTES

SITE INFORMATION

SITE ID: TXCA0977
SITE NAME: Carrollton Station
MARKET: DFW
CUSTOMER: CARRIER-A
ADDRESS: 1900 E Belt Line Rd (synthetic)
CITY: Carrollton
STATE: TX
ZIP: 75006
LATITUDE: 32.9537
LONGITUDE: -96.8903
STRUCTURE TYPE: Monopole
STRUCTURE HEIGHT (FT): 110
STRUCTURE OWNER: BluePeak Towers
PROJECT TYPE: 5G C-band add

GENERAL NOTES

CONTRACTOR SHALL VERIFY ALL DIMENSIONS AND EXISTING CONDITIONS BEFORE ORDERING MATERIAL.
ALL WORK PER CARRIER BUILD STANDARDS AND TIA-222-H.
RF CONFIGURATION PER RFDS R3.
MOUNT AND STRUCTURAL ADEQUACY PER MA/SA REPORTS.

MERIDIAN A&E GROUP
(SYNTHETIC SAMPLE)

CLIENT: ERICSSON
CARRIER: CARRIER-A

SITE ID: TXCA0977
SITE: CARROLLTON STATION
1900 E BELT LINE RD (SYNTH
CARROLLTON, TX 75006

STRUCTURE: MONOPOLE
HEIGHT: 110 FT

REV 1 2026-08-31
ISSUED FOR CONSTRUCTION


NOT FOR CONSTRUCTION -
SYNTHETIC POC DATA

SHEET TITLE:
TITLE SHEET & SCOPE OF WORK

SHEET T-1


RAD CENTER 105'-0"

RAD CENTER 98'-0"

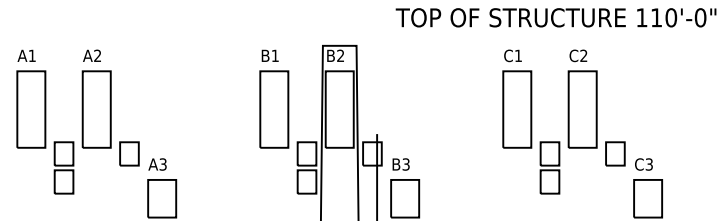

EQUIPMENT KEY

- A1 (E) NNH4-65B-R6 RC 105'
- A2 (E) APXVSPP18-C-A20 RC 105'
- A3 (P) AIR 6449 B77D RC 98'
- B1 (E) NNH4-65B-R6 RC 105'
- B2 (E) APXVSPP18-C-A20 RC 105'
- B3 (P) AIR 6449 B77D RC 98'
- C1 (E) NNH4-65B-R6 RC 105'
- C2 (E) APXVSPP18-C-A20 RC 105'
- C3 (P) AIR 6449 B77D RC 98'

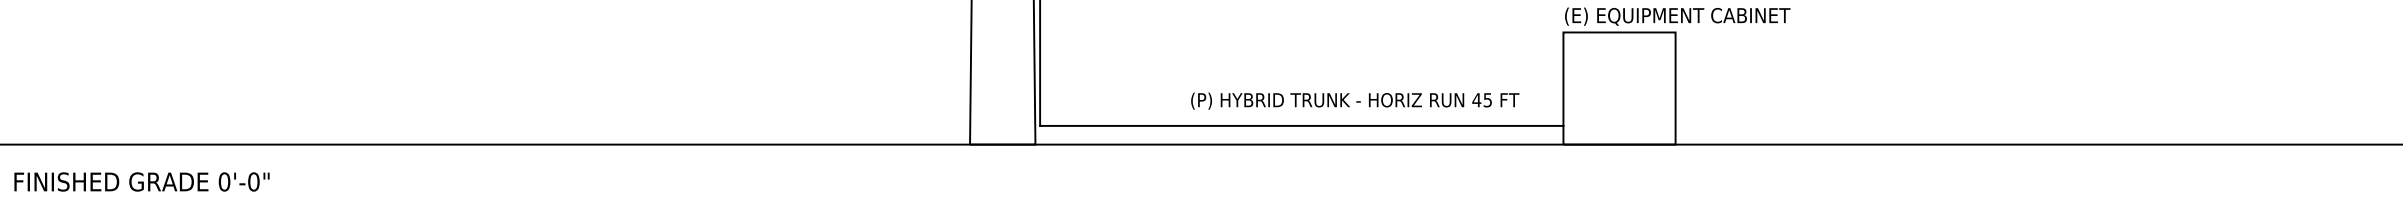

MERIDIAN A&E GROUP
(SYNTHETIC SAMPLE)

CLIENT: ERICSSON
CARRIER: CARRIER-A

SITE ID: TXCA0977
SITE: CARROLLTON STATION
1900 E BELT LINE RD (SYNTH
CARROLLTON, TX 75006

STRUCTURE: MONOPOLE
HEIGHT: 110 FT

REV 1 2026-08-31
ISSUED FOR CONSTRUCTION

NOT FOR CONSTRUCTION -
SYNTHETIC POC DATA

SHEET TITLE:
ELEVATION

SHEET A-2

N

REDLINE

ScopeIQ - 2026-10-07 - 2 markup(s) - status per ScopeIQ workflow

MERIDIAN A&E GROUP
(SYNTHETIC SAMPLE)

CLIENT: ERICSSON
CARRIER: CARRIER-A

SITE ID: TXCA0977
SITE: CARROLLTON STATION
1900 E BELT LINE RD (SYNTH
CARROLLTON, TX 75006

STRUCTURE: MONOPOLE
HEIGHT: 110 FT


REV 1 2026-08-31
ISSUED FOR CONSTRUCTION

NOT FOR CONSTRUCTION -
SYNTHETIC POC DATA

GAMMA 285 DEG

ALPHA 45 DEG

BETA 165 DEG

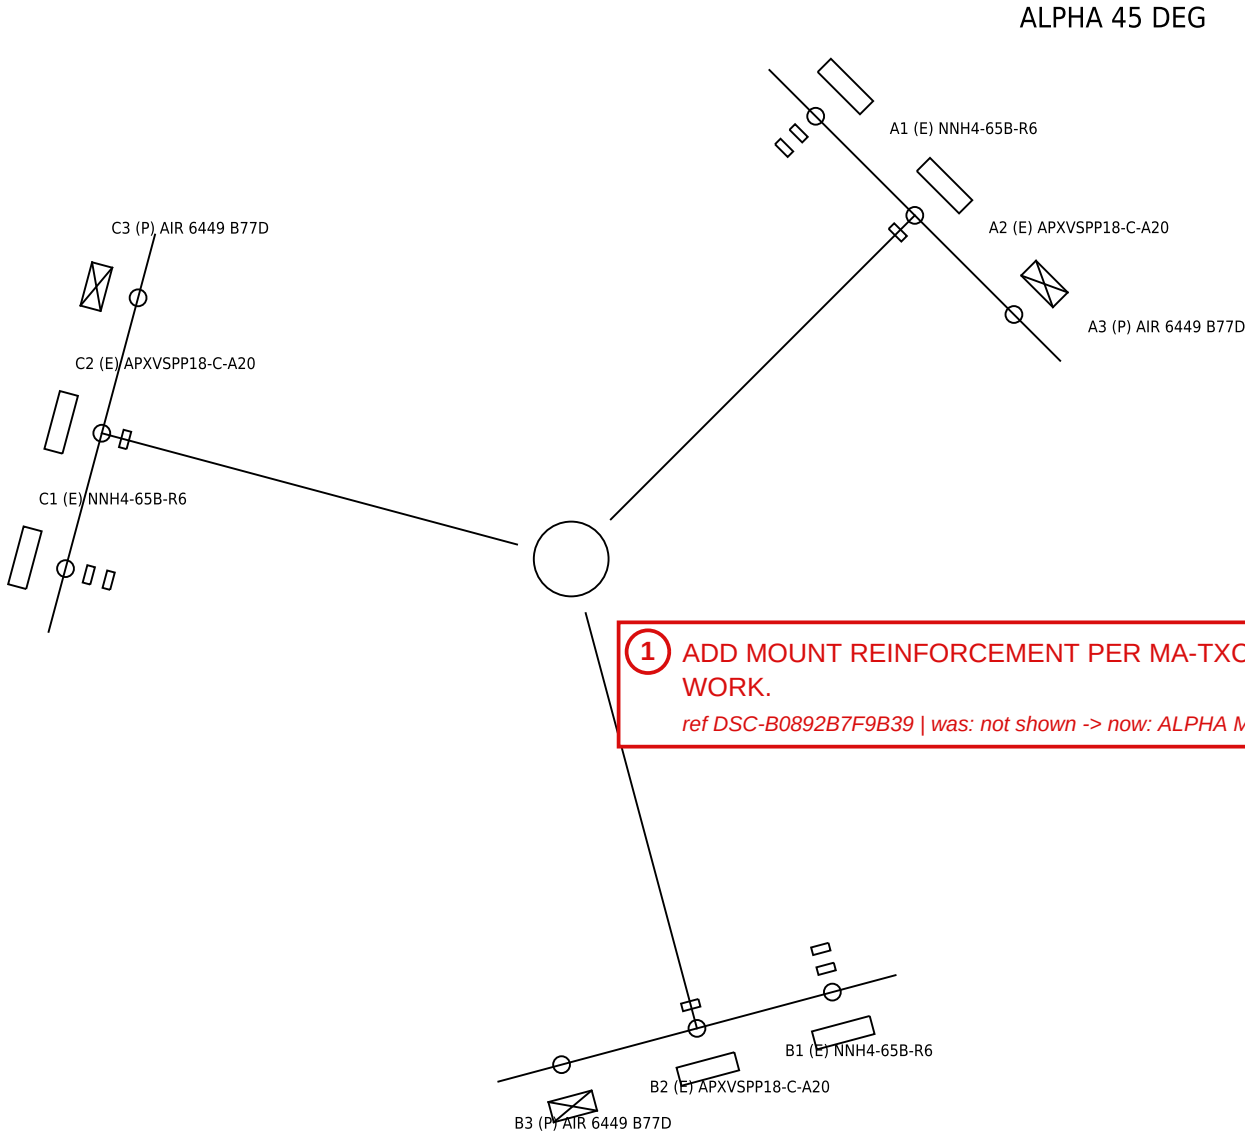

① ADD MOUNT REINFORCEMENT PER MA-TXCA0977-R0: ALPHA MRK x1. ADD TO T-1 SCOPE OF WORK.
ref DSC-B0892B7F9B39 | was: not shown -> now: ALPHA MRK x1

(E) EXISTING (P) PROPOSED (R) REMOVE. EQUIPMENT DATA HELD IN BLOCK ATTRIBUTES.

SHEET TITLE:
ANTENNA LAYOUT PLAN

SHEET A-3

ANTENNA & EQUIPMENT SCHEDULE

SECTOR	AZ	POS	STATUS	TYPE	MANUFACTURER	MODEL	RC (FT)	M-TILT	BANDS
ALPHA	45	1	EXISTING	ANTENNA	COMMSCOPE	NNH4-65B-R6	105	0	LB/MB
ALPHA	45	1	EXISTING	RRU	ERICSSON	RADIO 4449 B5 B12	105	-	B5/B12
ALPHA	45	1	EXISTING	RRU	ERICSSON	RADIO 4460 B2 B66	105	-	B2/B66
ALPHA	45	2	EXISTING	ANTENNA	RFS	APXVSP18-C-A20	105	2	MB
ALPHA	45	2	EXISTING	RRU	ERICSSON	RADIO 2217 B66A	105	-	B66
ALPHA	45	3	PROPOSED	AAU	ERICSSON	AIR 6449 B77D	98	1	n77
BETA	165	1	EXISTING	ANTENNA	COMMSCOPE	NNH4-65B-R6	105	0	LB/MB
BETA	165	1	EXISTING	RRU	ERICSSON	RADIO 4449 B5 B12	105	-	B5/B12
BETA	165	1	EXISTING	RRU	ERICSSON	RADIO 4460 B2 B66	105	-	B2/B66
BETA	165	2	EXISTING	ANTENNA	RFS	APXVSP18-C-A20	105	2	MB
BETA	165	2	EXISTING	RRU	ERICSSON	RADIO 2217 B66A	105	-	B66
BETA	165	3	PROPOSED	AAU	ERICSSON	AIR 6449 B77D	98	0	n77
GAMMA	285	1	EXISTING	ANTENNA	COMMSCOPE	NNH4-65B-R6	105	2	LB/MB
GAMMA	285	1	EXISTING	RRU	ERICSSON	RADIO 4449 B5 B12	105	-	B5/B12
GAMMA	285	1	EXISTING	RRU	ERICSSON	RADIO 4460 B2 B66	105	-	B2/B66
GAMMA	285	2	EXISTING	ANTENNA	RFS	APXVSP18-C-A20	105	1	MB
GAMMA	285	2	EXISTING	RRU	ERICSSON	RADIO 2217 B66A	105	-	B66
GAMMA	285	3	PROPOSED	AAU	ERICSSON	AIR 6449 B77D	98	2	n77

REDLINE

ScopeIQ - 2026-10-07 - 2 markup(s) - status per ScopeIQ workflow

CABLE SCHEDULE (REQ'D = 1.10 x (VERT + HORIZ))

TRUNK	TYPE	FROM	TO	VERT (FT)	HORIZ (FT)	REQ'D (FT)	SPECIFIED
T1	HYBRID 6x12	BASE OVP / CABINET	TOP OVP	103	45	162.8	200 FT

JUMPER SCHEDULE

JUMPER	ROUTE	LENGTH	QTY
DC JUMPER 8 AWG	TOP OVP TO RRU	15 FT	0
FIBER JUMPER LC-LC	TOP OVP TO RRU	15 FT	0
DC JUMPER 8 AWG	TOP OVP TO AAU	20 FT	3
FIBER JUMPER LC-LC	TOP OVP TO AAU	20 FT	3

2 REVISE CABLE SCHEDULE HORIZ RUN 45 FT -> 18 FT (MEASURED). RECOMPUTE REQ'D LENGTH AND SPECIFIED TRUNK.

ref DSC-BCDF44AF6EA7 | was: 45 ft -> now: 18 ft

MERIDIAN A&E GROUP

(SYNTHETIC SAMPLE)

CLIENT: ERICSSON

CARRIER: CARRIER-A

SITE ID: TXCA0977

SITE: CARROLLTON STATION

1900 E BELT LINE RD (SYNTH

CARROLLTON, TX 75006

STRUCTURE: MONOPOLE

HEIGHT: 110 FT

REV 1 2026-08-31

ISSUED FOR CONSTRUCTION

NOT FOR CONSTRUCTION -


SYNTHETIC POC DATA

SHEET TITLE:

ANTENNA & CABLE SCHEDULE

SHEET A-4

GROUNDING PLAN

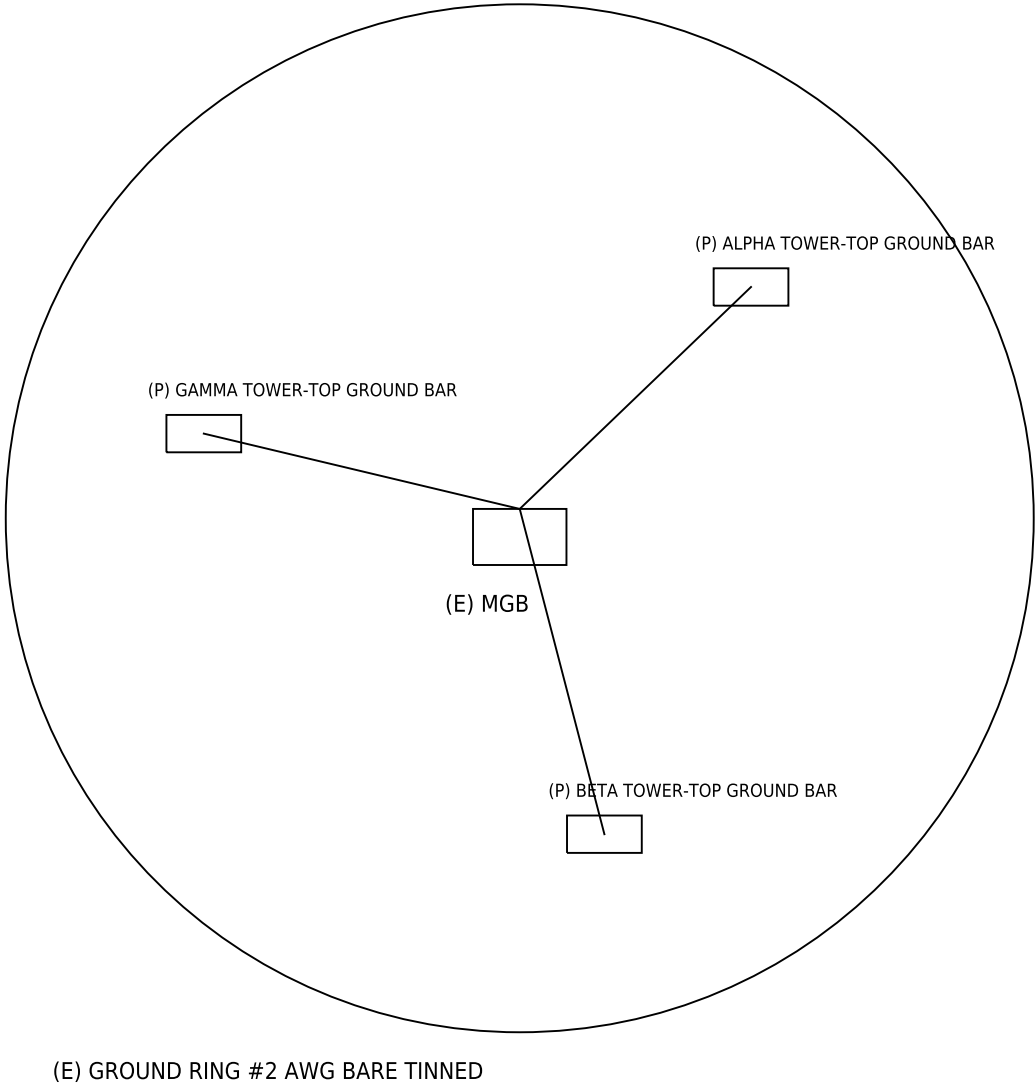

- 1. BOND EACH NEW RRU, AAU AND ANTENNA TO SECTOR GROUND BAR WITH #6 AWG.
- 2. GROUND HYBRID TRUNK AT TOP, BOTTOM AND MID-SPAN IF > 200 FT.
- 3. BOND TOP AND BASE OVP ENCLOSURES WITH #6 AWG.
- 4. ALL LUGS TWO-HOLE, TINNED, WITH ANTI-OXIDANT.

MERIDIAN A&E GROUP
(SYNTHETIC SAMPLE)

CLIENT: ERICSSON
CARRIER: CARRIER-A

SITE ID: TXCA0977
SITE: CARROLLTON STATION
1900 E BELT LINE RD (SYNTH
CARROLLTON, TX 75006

STRUCTURE: MONOPOLE
HEIGHT: 110 FT

REV 1 2026-08-31
ISSUED FOR CONSTRUCTION

NOT FOR CONSTRUCTION -
SYNTHETIC POC DATA

SHEET TITLE:
GROUNDING PLAN & NOTES

SHEET E-1