

REDLINE SUMMARY - TXFW2217 CD REV 1

ScopelQ - 2026-10-07 - 1 markup(s) - status per ScopelQ workflow

#	SHEET	MARKUP	FROM	TO	STATUS
1	A-3	REVISE ALPHA AZIMUTH 20 -> 30 DEG PER RFDS R3 (SUBJECT TO RFI).	20 deg	30 deg	DRAFT

CARRIER-A - 5G C-BAND ADD

TXFW2217 FOSSIL CREEK

SCOPE OF WORK

- 1. INSTALL (3) AIR 6449 B77D
- 2. INSTALL (1) BASEBAND 6648 IN EXISTING CABINET
- 3. INSTALL (1) HYBRID TRUNK 6x12, 250 FT, WITH TOP AND BASE OVP
- 4. FIELD VERIFY ALL EXISTING CONDITIONS PRIOR TO CONSTRUCTION

SHEET INDEX

- T-1 TITLE SHEET & SCOPE OF WORK
- A-2 ELEVATION
- A-3 ANTENNA LAYOUT PLAN
- A-4 ANTENNA & CABLE SCHEDULE
- E-1 GROUNDING PLAN & NOTES

SITE INFORMATION

SITE ID: TXFW2217
SITE NAME: Fossil Creek
MARKET: DFW
CUSTOMER: CARRIER-A
ADDRESS: 3900 Basswood Blvd (synthetic)
CITY: Fort Worth
STATE: TX
ZIP: 76137
LATITUDE: 32.8733
LONGITUDE: -97.3065
STRUCTURE TYPE: Self-support tower
STRUCTURE HEIGHT (FT): 180
STRUCTURE OWNER: Trinity Structures
PROJECT TYPE: 5G C-band add

GENERAL NOTES

CONTRACTOR SHALL VERIFY ALL DIMENSIONS AND EXISTING CONDITIONS BEFORE ORDERING MATERIAL.
ALL WORK PER CARRIER BUILD STANDARDS AND TIA-222-H.
RF CONFIGURATION PER RFDS R3.
MOUNT AND STRUCTURAL ADEQUACY PER MA/SA REPORTS.

MERIDIAN A&E GROUP
(SYNTHETIC SAMPLE)

CLIENT: ERICSSON
CARRIER: CARRIER-A

SITE ID: TXFW2217
SITE: FOSSIL CREEK
3900 BASSWOOD BLVD (SYNTHE
FORT WORTH, TX 76137

STRUCTURE: SELF-SUPPORT TOWER
HEIGHT: 180 FT

REV 1 2026-08-21
ISSUED FOR CONSTRUCTION


NOT FOR CONSTRUCTION -
SYNTHETIC POC DATA

SHEET TITLE:
TITLE SHEET & SCOPE OF WORK

SHEET T-1

RAD CENTER 175'-0"

RAD CENTER 168'-0"

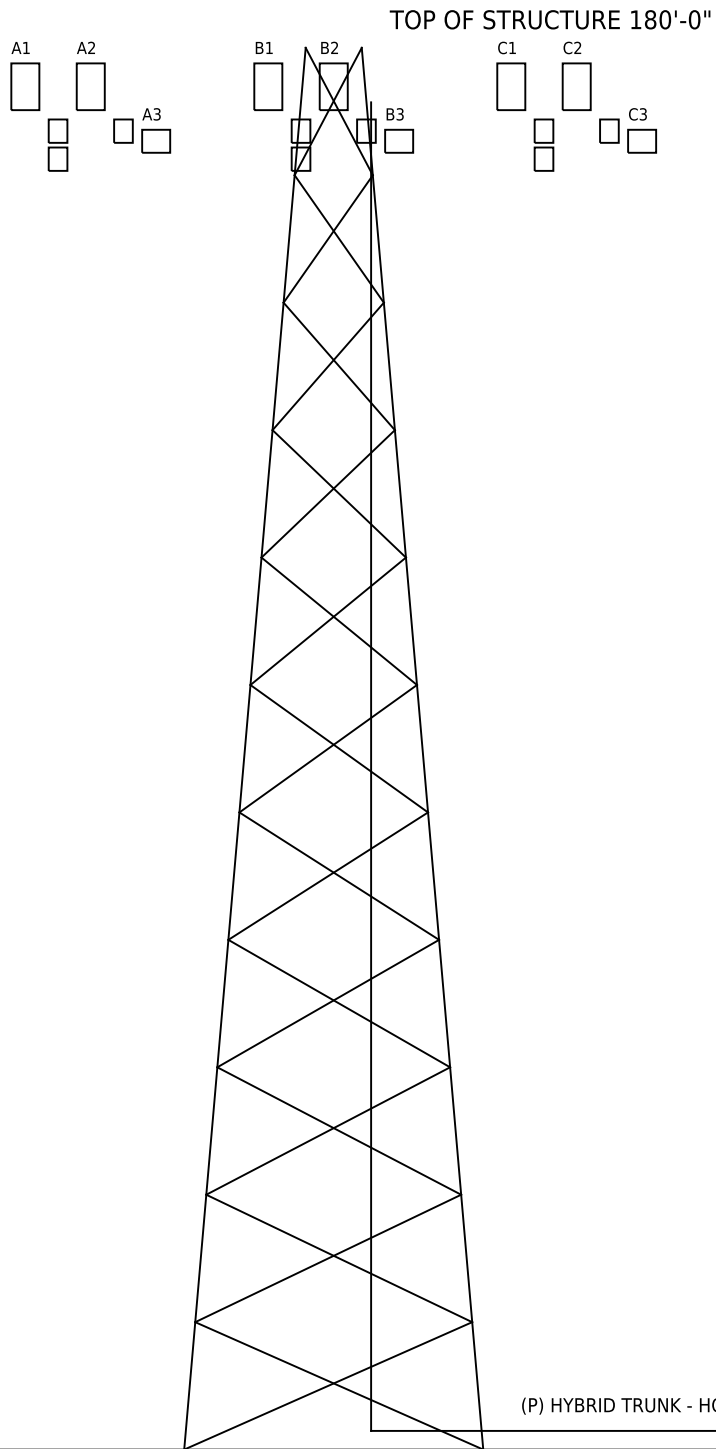

EQUIPMENT KEY

- A1 (E) NNH4-65B-R6 RC 175'
- A2 (E) APXVSPP18-C-A20 RC 175'
- A3 (P) AIR 6449 B77D RC 168'
- B1 (E) NNH4-65B-R6 RC 175'
- B2 (E) APXVSPP18-C-A20 RC 175'
- B3 (P) AIR 6449 B77D RC 168'
- C1 (E) NNH4-65B-R6 RC 175'
- C2 (E) APXVSPP18-C-A20 RC 175'
- C3 (P) AIR 6449 B77D RC 168'

MERIDIAN A&E GROUP

(SYNTHETIC SAMPLE)

CLIENT: ERICSSON

CARRIER: CARRIER-A

SITE ID: TXFW2217

SITE: FOSSIL CREEK

3900 BASSWOOD BLVD (SYNTHE

FORT WORTH, TX 76137

STRUCTURE: SELF-SUPPORT TOWER

HEIGHT: 180 FT

REV 1 2026-08-21

ISSUED FOR CONSTRUCTION

NOT FOR CONSTRUCTION -

SYNTHETIC POC DATA

FINISHED GRADE 0'-0"

SHEET TITLE:

ELEVATION

SHEET A-2

N

REDLINE

ScopeIQ - 2026-10-07 - 1 markup(s) - status per ScopeIQ workflow

MERIDIAN A&E GROUP
(SYNTHETIC SAMPLE)

CLIENT: ERICSSON
CARRIER: CARRIER-A

SITE ID: TXFW2217
SITE: FOSSIL CREEK
3900 BASSWOOD BLVD (SYNTHE
FORT WORTH, TX 76137

STRUCTURE: SELF-SUPPORT TOWER
HEIGHT: 180 FT

REV 1 2026-08-21
ISSUED FOR CONSTRUCTION

NOT FOR CONSTRUCTION -
SYNTHETIC POC DATA

ALPHA 20 DEG

GAMMA 250 DEG

BETA 130 DEG

1 REVISE ALPHA AZIMUTH 20 -> 30 DEG PER RFDS R3 (SUBJECT TO RFI).
ref DSC-C6623AE55EB8 | was: 20 deg -> now: 30 deg

(E) EXISTING (P) PROPOSED (R) REMOVE. EQUIPMENT DATA HELD IN BLOCK ATTRIBUTES.

SHEET TITLE:
ANTENNA LAYOUT PLAN

SHEET A-3

ANTENNA & EQUIPMENT SCHEDULE

SECTOR	AZ	POS	STATUS	TYPE	MANUFACTURER	MODEL	RC (FT)	M-TILT	BANDS
ALPHA	20	1	EXISTING	ANTENNA	COMMSCOPE	NNH4-65B-R6	175	0	LB/MB
ALPHA	20	1	EXISTING	RRU	ERICSSON	RADIO 4449 B5 B12	175	-	B5/B12
ALPHA	20	1	EXISTING	RRU	ERICSSON	RADIO 4460 B2 B66	175	-	B2/B66
ALPHA	20	2	EXISTING	ANTENNA	RFS	APXVSP18-C-A20	175	1	MB
ALPHA	20	2	EXISTING	RRU	ERICSSON	RADIO 2217 B66A	175	-	B66
ALPHA	20	3	PROPOSED	AAU	ERICSSON	AIR 6449 B77D	168	1	n77
BETA	130	1	EXISTING	ANTENNA	COMMSCOPE	NNH4-65B-R6	175	0	LB/MB
BETA	130	1	EXISTING	RRU	ERICSSON	RADIO 4449 B5 B12	175	-	B5/B12
BETA	130	1	EXISTING	RRU	ERICSSON	RADIO 4460 B2 B66	175	-	B2/B66
BETA	130	2	EXISTING	ANTENNA	RFS	APXVSP18-C-A20	175	0	MB
BETA	130	2	EXISTING	RRU	ERICSSON	RADIO 2217 B66A	175	-	B66
BETA	130	3	PROPOSED	AAU	ERICSSON	AIR 6449 B77D	168	1	n77
GAMMA	250	1	EXISTING	ANTENNA	COMMSCOPE	NNH4-65B-R6	175	1	LB/MB
GAMMA	250	1	EXISTING	RRU	ERICSSON	RADIO 4449 B5 B12	175	-	B5/B12
GAMMA	250	1	EXISTING	RRU	ERICSSON	RADIO 4460 B2 B66	175	-	B2/B66
GAMMA	250	2	EXISTING	ANTENNA	RFS	APXVSP18-C-A20	175	2	MB
GAMMA	250	2	EXISTING	RRU	ERICSSON	RADIO 2217 B66A	175	-	B66
GAMMA	250	3	PROPOSED	AAU	ERICSSON	AIR 6449 B77D	168	1	n77

CABLE SCHEDULE (REQ'D = 1.10 x (VERT + HORIZ))

TRUNK	TYPE	FROM	TO	VERT (FT)	HORIZ (FT)	REQ'D (FT)	SPECIFIED
T1	HYBRID 6x12	BASE OVP / CABINET	TOP OVP	173	30	223.3	250 FT

JUMPER SCHEDULE

JUMPER	ROUTE	LENGTH	QTY
DC JUMPER 8 AWG	TOP OVP TO RRU	15 FT	0
FIBER JUMPER LC-LC	TOP OVP TO RRU	15 FT	0
DC JUMPER 8 AWG	TOP OVP TO AAU	20 FT	3
FIBER JUMPER LC-LC	TOP OVP TO AAU	20 FT	3

MERIDIAN A&E GROUP
(SYNTHETIC SAMPLE)

CLIENT: ERICSSON

CARRIER: CARRIER-A

SITE ID: TXFW2217

SITE: FOSSIL CREEK

3900 BASSWOOD BLVD (SYNTHETIC)
FORT WORTH, TX 76137

STRUCTURE: SELF-SUPPORT TOWER

HEIGHT: 180 FT


REV 1 2026-08-21

ISSUED FOR CONSTRUCTION

NOT FOR CONSTRUCTION -

SYNTHETIC POC DATA

GROUNDING PLAN

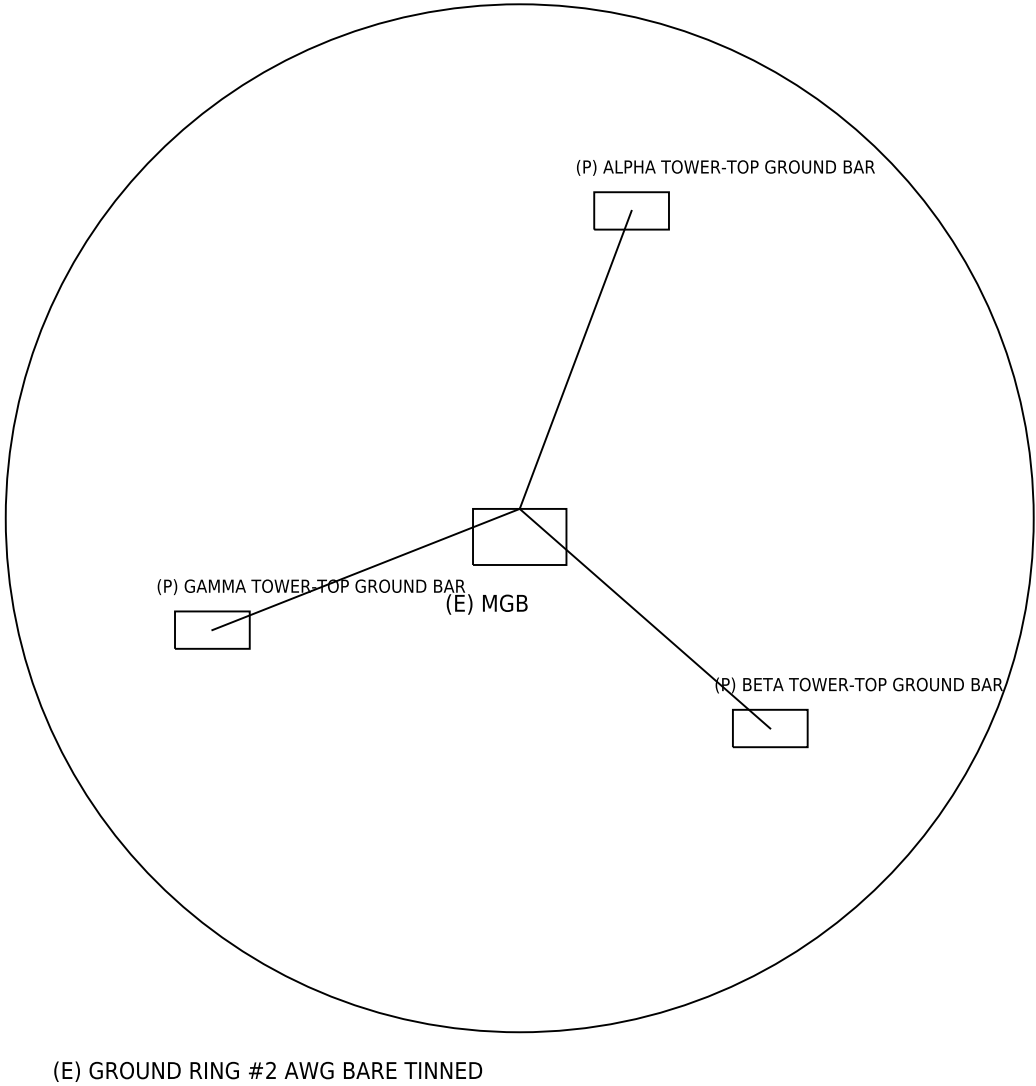

- 1. BOND EACH NEW RRU, AAU AND ANTENNA TO SECTOR GROUND BAR WITH #6 AWG.
- 2. GROUND HYBRID TRUNK AT TOP, BOTTOM AND MID-SPAN IF > 200 FT.
- 3. BOND TOP AND BASE OVP ENCLOSURES WITH #6 AWG.
- 4. ALL LUGS TWO-HOLE, TINNED, WITH ANTI-OXIDANT.

MERIDIAN A&E GROUP
(SYNTHETIC SAMPLE)

CLIENT: ERICSSON
CARRIER: CARRIER-A

SITE ID: TXFW2217
SITE: FOSSIL CREEK
3900 BASSWOOD BLVD (SYNTHETIC)
FORT WORTH, TX 76137

STRUCTURE: SELF-SUPPORT TOWER
HEIGHT: 180 FT

REV 1 2026-08-21
ISSUED FOR CONSTRUCTION

NOT FOR CONSTRUCTION -
SYNTHETIC POC DATA

SHEET TITLE:
GROUNDING PLAN & NOTES