

REDLINE SUMMARY - TXGR0719 CD REV 1

ScopelQ - 2026-10-07 - 2 markup(s) - status per ScopelQ workflow

#	SHEET	MARKUP	FROM	TO	STATUS
1	A-3	ADD (P) RADIO 4460 B2 B66 AT BETA POS 1 PER RFDS R3; UPDATE A-4 SCHEDULE AND T-1 SCOPE.	not shown	(P) R4460	DRAFT
2	A-4	REVISE CABLE SCHEDULE HORIZ RUN 40 FT -> 80 FT (MEASURED). RECOMPUTE REQ'D LENGTH AND SPECIFIED TRUNK.	40 ft	80 ft	DRAFT

CARRIER-A - FULL SITE MODERNIZATION

TXGR0719 ARBOR BEND

SCOPE OF WORK

1. INSTALL (3) NNH4-65B-R6
2. INSTALL (3) RADIO 4449 B5 B12
3. INSTALL (2) RADIO 4460 B2 B66
4. INSTALL (3) AIR 6449 B77D
5. INSTALL (3) AIR 6419 B41
6. REMOVE (3) SBNHH-1D65B
7. REMOVE (3) RRUS 11 B12
8. REMOVE (3) APXVSP18-C-A20
9. REMOVE (3) RADIO 2217 B66A
10. INSTALL (1) BASEBAND 6648 IN EXISTING CABINET
11. INSTALL (1) BASEBAND 6651 IN EXISTING CABINET
12. INSTALL (2) HYBRID TRUNK 6x12, 300 FT, WITH TOP AND BASE OVP
13. REPLACE EXISTING T-ARMS WITH NEW 12 FT SECTOR FRAMES
14. FIELD VERIFY ALL EXISTING CONDITIONS PRIOR TO CONSTRUCTION

SHEET INDEX

- T-1 TITLE SHEET & SCOPE OF WORK
- A-2 ELEVATION
- A-3 ANTENNA LAYOUT PLAN
- A-4 ANTENNA & CABLE SCHEDULE
- E-1 GROUNDING PLAN & NOTES

SITE INFORMATION

SITE ID: TXGR0719

SITE NAME: Arbor Bend

MARKET: DFW

CUSTOMER: CARRIER-A

ADDRESS: 2400 S Great Southwest Pkwy (synthetic)

CITY: Grand Prairie

STATE: TX

ZIP: 75052

LATITUDE: 32.7092

LONGITUDE: -97.0143

STRUCTURE TYPE: Self-support tower

STRUCTURE HEIGHT (FT): 195

STRUCTURE OWNER: Trinity Structures

PROJECT TYPE: Full site modernization

GENERAL NOTES

CONTRACTOR SHALL VERIFY ALL DIMENSIONS AND EXISTING

CONDITIONS BEFORE ORDERING MATERIAL.

ALL WORK PER CARRIER BUILD STANDARDS AND TIA-222-H.

RF CONFIGURATION PER RFDS R3.

MOUNT AND STRUCTURAL ADEQUACY PER MA/SA REPORTS.

MERIDIAN A&E GROUP

(SYNTHETIC SAMPLE)

CLIENT: ERICSSON

CARRIER: CARRIER-A

SITE ID: TXGR0719

SITE: ARBOR BEND

2400 S GREAT SOUTHWEST PKW

GRAND PRAIRIE, TX 75052

STRUCTURE: SELF-SUPPORT TOWER

HEIGHT: 195 FT

REV 1 2026-08-24

ISSUED FOR CONSTRUCTION

NOT FOR CONSTRUCTION -


SYNTHETIC POC DATA

SHEET TITLE:

TITLE SHEET & SCOPE OF WORK

SHEET T-1

RAD CENTER 190'-0"

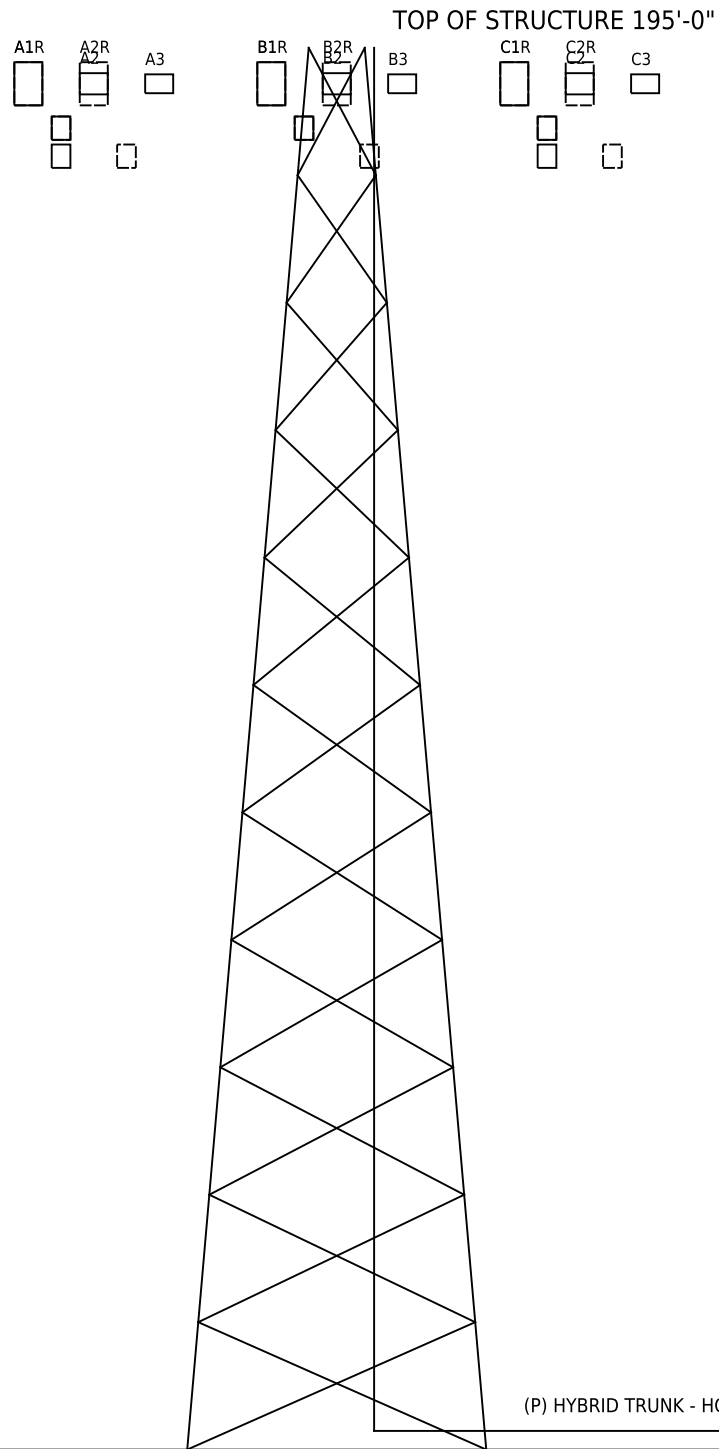

EQUIPMENT KEY

A1R (R) SBNHH-1D65B RC 190'

A2R (R) APXVSPP18-C-A20 RC 190'

A1 (P) NNH4-65B-R6 RC 190'

A2 (P) AIR 6449 B77D RC 190'

A3 (P) AIR 6419 B41 RC 190'

B1R (R) SBNHH-1D65B RC 190'

B2R (R) APXVSPP18-C-A20 RC 190'

B1 (P) NNH4-65B-R6 RC 190'

B2 (P) AIR 6449 B77D RC 190'

B3 (P) AIR 6419 B41 RC 190'

C1R (R) SBNHH-1D65B RC 190'

C2R (R) APXVSPP18-C-A20 RC 190'

C1 (P) NNH4-65B-R6 RC 190'

C2 (P) AIR 6449 B77D RC 190'

C3 (P) AIR 6419 B41 RC 190'

MERIDIAN A&E GROUP
(SYNTHETIC SAMPLE)

CLIENT: ERICSSON
CARRIER: CARRIER-A

SITE ID: TXGR0719
SITE: ARBOR BEND
2400 S GREAT SOUTHWEST PKW
GRAND PRAIRIE, TX 75052

STRUCTURE: SELF-SUPPORT TOWER
HEIGHT: 195 FT

REV 1 2026-08-24
ISSUED FOR CONSTRUCTION

NOT FOR CONSTRUCTION -
SYNTHETIC POC DATA

FINISHED GRADE 0'-0"

SHEET TITLE:
ELEVATION

SHEET A-2

N

REDLINE

ScopeIQ - 2026-10-07 - 2 markup(s) - status per ScopeIQ workflow

MERIDIAN A&E GROUP
(SYNTHETIC SAMPLE)


CLIENT: ERICSSON
CARRIER: CARRIER-A

SITE ID: TXGR0719
SITE: ARBOR BEND
2400 S GREAT SOUTHWEST PKW
GRAND PRAIRIE, TX 75052

STRUCTURE: SELF-SUPPORT TOWER
HEIGHT: 195 FT

REV 1 2026-08-24
ISSUED FOR CONSTRUCTION

NOT FOR CONSTRUCTION -
SYNTHETIC POC DATA

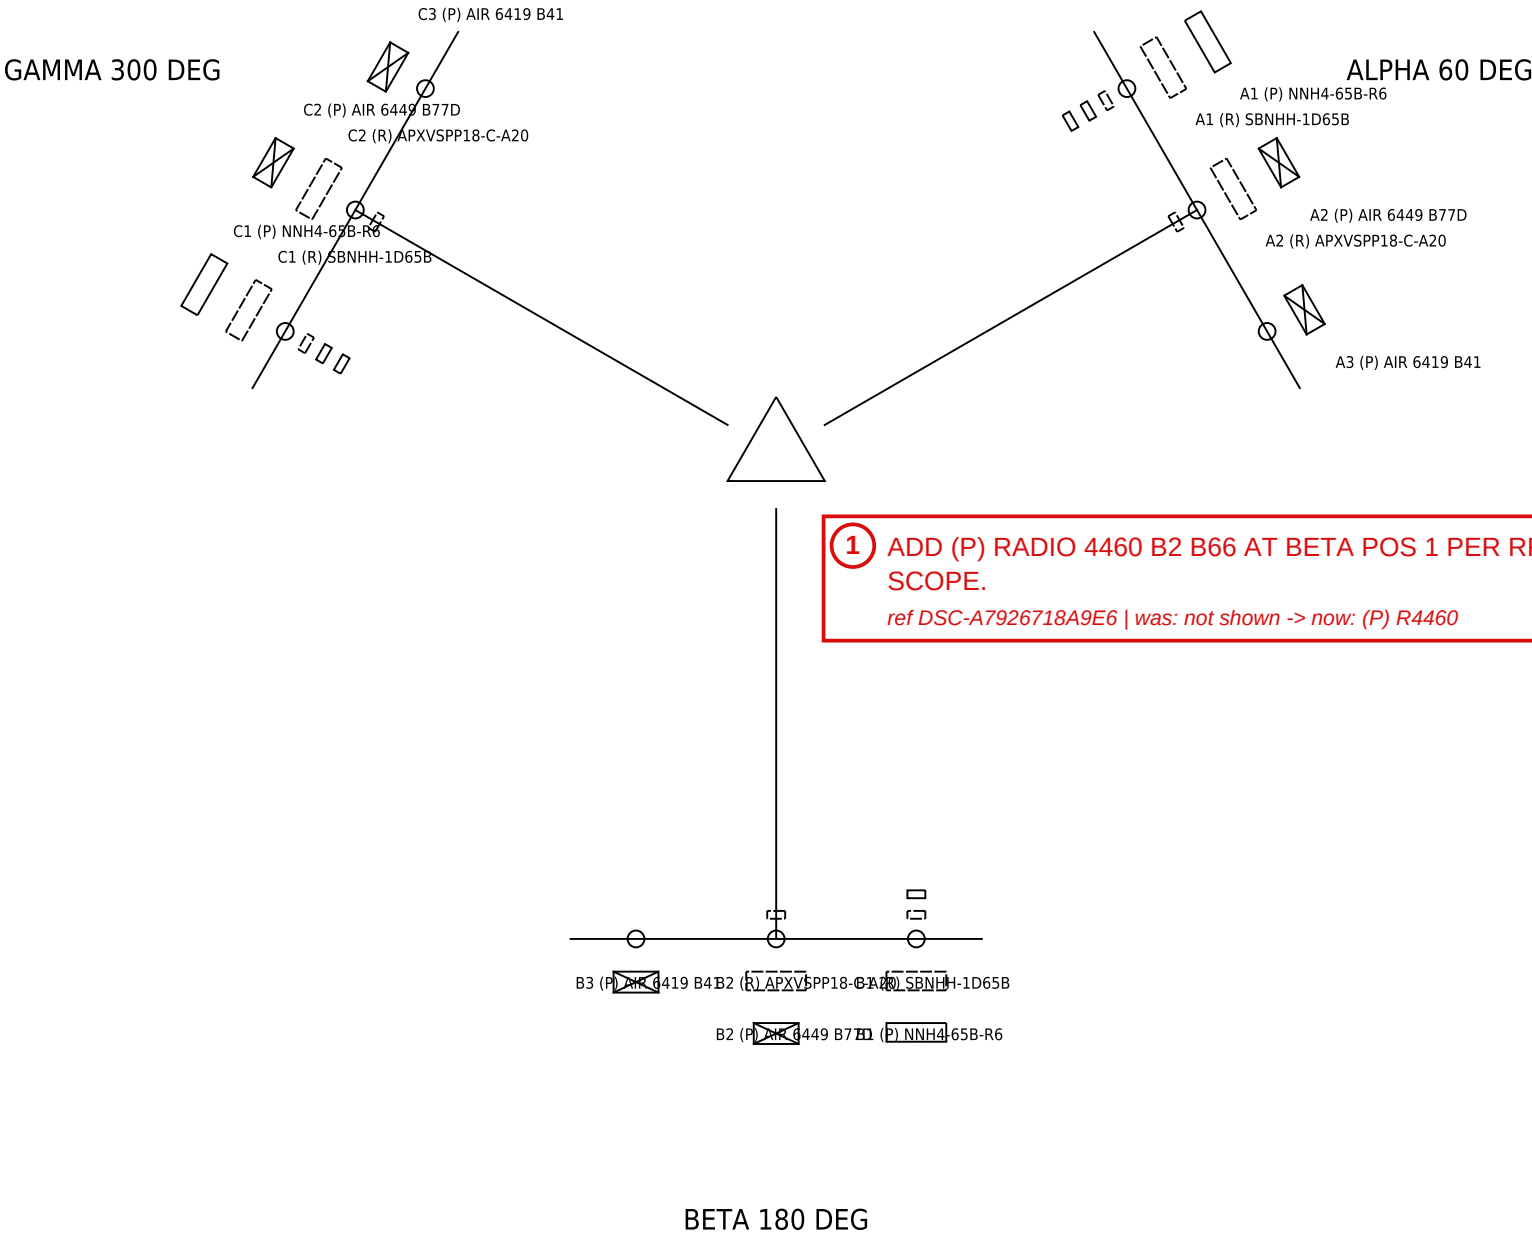

(E) EXISTING (P) PROPOSED (R) REMOVE. EQUIPMENT DATA HELD IN BLOCK ATTRIBUTES.

SHEET TITLE:
ANTENNA LAYOUT PLAN

SHEET A-3

ANTENNA & EQUIPMENT SCHEDULE

SECTOR	AZ	POS	STATUS	TYPE	MANUFACTURER	MODEL	RC (FT)	M-TILT	BANDS
ALPHA	60	1	REMOVE	ANTENNA	COMMSCOPE	SBNHH-1D65B	190	2	LB/MB
ALPHA	60	1	PROPOSED	ANTENNA	COMMSCOPE	NNH4-65B-R6	190	2	LB/MB
ALPHA	60	1	REMOVE	RRU	ERICSSON	RRUS 11 B12	190	-	B12
ALPHA	60	1	PROPOSED	RRU	ERICSSON	RADIO 4449 B5 B12	190	-	B5/B12
ALPHA	60	1	PROPOSED	RRU	ERICSSON	RADIO 4460 B2 B66	190	-	B2/B66
ALPHA	60	2	REMOVE	ANTENNA	RFS	APXVSP18-C-A20	190	1	MB
ALPHA	60	2	PROPOSED	AAU	ERICSSON	AIR 6449 B77D	190	1	n77
ALPHA	60	2	REMOVE	RRU	ERICSSON	RADIO 2217 B66A	190	-	B66
ALPHA	60	3	PROPOSED	AAU	ERICSSON	AIR 6419 B41	190	2	n41
BETA	180	1	REMOVE	ANTENNA	COMMSCOPE	SBNHH-1D65B	190	0	LB/MB
BETA	180	1	PROPOSED	ANTENNA	COMMSCOPE	NNH4-65B-R6	190	0	LB/MB
BETA	180	1	REMOVE	RRU	ERICSSON	RRUS 11 B12	190	-	B12
BETA	180	1	PROPOSED	RRU	ERICSSON	RADIO 4449 B5 B12	190	-	B5/B12
BETA	180	2	REMOVE	ANTENNA	RFS	APXVSP18-C-A20	190	1	MB
BETA	180	2	PROPOSED	AAU	ERICSSON	AIR 6449 B77D	190	1	n77
BETA	180	2	REMOVE	RRU	ERICSSON	RADIO 2217 B66A	190	-	B66
BETA	180	3	PROPOSED	AAU	ERICSSON	AIR 6419 B41	190	0	n41
GAMMA	300	1	REMOVE	ANTENNA	COMMSCOPE	SBNHH-1D65B	190	0	LB/MB
GAMMA	300	1	PROPOSED	ANTENNA	COMMSCOPE	NNH4-65B-R6	190	0	LB/MB
GAMMA	300	1	REMOVE	RRU	ERICSSON	RRUS 11 B12	190	-	B12
GAMMA	300	1	PROPOSED	RRU	ERICSSON	RADIO 4449 B5 B12	190	-	B5/B12
GAMMA	300	1	PROPOSED	RRU	ERICSSON	RADIO 4460 B2 B66	190	-	B2/B66
GAMMA	300	2	REMOVE	ANTENNA	RFS	APXVSP18-C-A20	190	1	MB
GAMMA	300	2	PROPOSED	AAU	ERICSSON	AIR 6449 B77D			
GAMMA	300	2	REMOVE	RRU	ERICSSON	RADIO 2217 B66A			
GAMMA	300	3	PROPOSED	AAU	ERICSSON	AIR 6419 B41			

REDLINE

ScopeIQ - 2026-10-07 - 2 markup(s) - status per ScopeIQ workflow

2 REVISE CABLE SCHEDULE HORIZ RUN 40 FT -> 80 FT (MEASURED). RECOMPUTE REQ'D LENGTH AND SPECIFIED TRUNK.
ref DSC-E2E9CBE1E920 | was: 40 ft -> now: 80 ft

CABLE SCHEDULE (REQ'D = 1.10 x (VERT + HORIZ))

TRUNK	TYPE	FROM	TO	VERT (FT)	HORIZ (FT)	REQ'D (FT)	SPECIFIED
T1	HYBRID 6x12	BASE OVP / CABINET	TOP OVP	195	40	258.5	300 FT
T2	HYBRID 6x12	BASE OVP / CABINET	TOP OVP	195	40	258.5	300 FT

JUMPER SCHEDULE

JUMPER	ROUTE	LENGTH	QTY
DC JUMPER 8 AWG	TOP OVP TO RRU	15 FT	5
FIBER JUMPER LC-LC	TOP OVP TO RRU	15 FT	5
DC JUMPER 8 AWG	TOP OVP TO AAU	20 FT	6
FIBER JUMPER LC-LC	TOP OVP TO AAU	20 FT	6

MERIDIAN A&E GROUP
(SYNTHETIC SAMPLE)

CLIENT: ERICSSON
CARRIER: CARRIER-A

SITE ID: TXGR0719
SITE: ARBOR BEND
2400 S GREAT SOUTHWEST PKW
GRAND PRAIRIE, TX 75052

STRUCTURE: SELF-SUPPORT TOWER
HEIGHT: 195 FT


REV 1 2026-08-24
ISSUED FOR CONSTRUCTION

NOT FOR CONSTRUCTION -
SYNTHETIC POC DATA

SHEET TITLE:
ANTENNA & CABLE SCHEDULE

SHEET A-4

GROUNDING PLAN

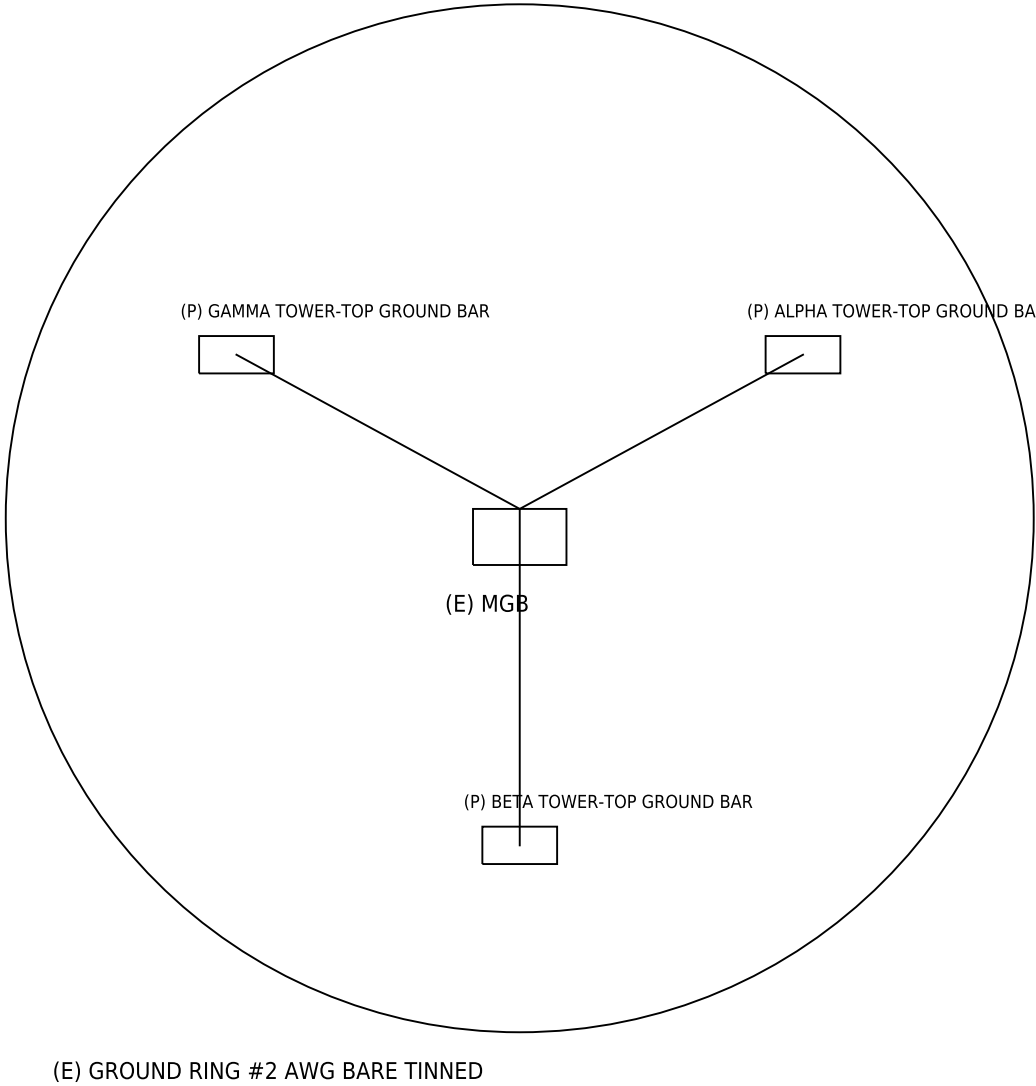

- 1. BOND EACH NEW RRU, AAU AND ANTENNA TO SECTOR GROUND BAR WITH #6 AWG.
- 2. GROUND HYBRID TRUNK AT TOP, BOTTOM AND MID-SPAN IF > 200 FT.
- 3. BOND TOP AND BASE OVP ENCLOSURES WITH #6 AWG.
- 4. ALL LUGS TWO-HOLE, TINNED, WITH ANTI-OXIDANT.

MERIDIAN A&E GROUP
(SYNTHETIC SAMPLE)

CLIENT: ERICSSON
CARRIER: CARRIER-A

SITE ID: TXGR0719
SITE: ARBOR BEND
2400 S GREAT SOUTHWEST PKW
GRAND PRAIRIE, TX 75052

STRUCTURE: SELF-SUPPORT TOWER
HEIGHT: 195 FT

REV 1 2026-08-24
ISSUED FOR CONSTRUCTION

NOT FOR CONSTRUCTION -
SYNTHETIC POC DATA

SHEET TITLE:
GROUNDING PLAN & NOTES

SHEET E-1