

# REDLINE SUMMARY - TXIR1340 CD REV 1

ScopelQ - 2026-10-07 - 1 markup(s) - status per ScopelQ workflow

| # | SHEET | MARKUP                                                                                        | FROM    | TO                    | STATUS |
|---|-------|-----------------------------------------------------------------------------------------------|---------|-----------------------|--------|
| 1 | A-2   | REVISE RAD CENTER OF EXISTING ANTENNAS 135 FT -> 130.7/130.8/130.9/131.2/131.4 FT (MEASURED). | [135.0] | [130.7, 130.8, 130.9, | DRAFT  |

# CARRIER-A - 5G C-BAND ADD

## TXIR1340 VALLEY RANCH

### SCOPE OF WORK

- 1. INSTALL (3) AIR 6449 B77D
- 2. INSTALL (1) BASEBAND 6648 IN EXISTING CABINET
- 3. INSTALL (1) HYBRID TRUNK 6x12, 200 FT, WITH TOP AND BASE OVP
- 4. FIELD VERIFY ALL EXISTING CONDITIONS PRIOR TO CONSTRUCTION

### SHEET INDEX

- T-1 TITLE SHEET & SCOPE OF WORK
- A-2 ELEVATION
- A-3 ANTENNA LAYOUT PLAN
- A-4 ANTENNA & CABLE SCHEDULE
- E-1 GROUNDING PLAN & NOTES

### SITE INFORMATION

SITE ID: TXIR1340  
SITE NAME: Valley Ranch  
MARKET: DFW  
CUSTOMER: CARRIER-A  
ADDRESS: 9100 N MacArthur Blvd (synthetic)  
CITY: Irving  
STATE: TX  
ZIP: 75063  
LATITUDE: 32.9234  
LONGITUDE: -96.9587  
STRUCTURE TYPE: Monopole  
STRUCTURE HEIGHT (FT): 140  
STRUCTURE OWNER: BluePeak Towers  
PROJECT TYPE: 5G C-band add

### GENERAL NOTES

CONTRACTOR SHALL VERIFY ALL DIMENSIONS AND EXISTING CONDITIONS BEFORE ORDERING MATERIAL.  
ALL WORK PER CARRIER BUILD STANDARDS AND TIA-222-H.  
RF CONFIGURATION PER RFDS R3.  
MOUNT AND STRUCTURAL ADEQUACY PER MA/SA REPORTS.

MERIDIAN A&E GROUP  
(SYNTHETIC SAMPLE)

CLIENT: ERICSSON  
CARRIER: CARRIER-A

SITE ID: TXIR1340  
SITE: VALLEY RANCH  
9100 N MACARTHUR BLVD (SYN  
IRVING, TX 75063

STRUCTURE: MONOPOLE  
HEIGHT: 140 FT

REV 1 2026-08-23  
ISSUED FOR CONSTRUCTION

NOT FOR CONSTRUCTION -  
SYNTHETIC POC DATA

SHEET TITLE:  
TITLE SHEET & SCOPE OF WORK

SHEET T-1

REDLINE

EQUIPMENT KEY

ScopeIQ - 2026-10-07 - 1 markup(s) - status per ScopeIQ workflow

A1 (E) NNH4-65B-R6 RC 135'

A2 (E) APXVSPP18-C-A20 RC 135'

A3 (P) AIR 6449 B77D RC 128'

B1 (E) NNH4-65B-R6 RC 135'

B2 (E) APXVSPP18-C-A20 RC 135'

B3 (P) AIR 6449 B77D RC 128'

C1 (E) NNH4-65B-R6 RC 135'

C2 (E) APXVSPP18-C-A20 RC 135'

C3 (P) AIR 6449 B77D RC 128'

MERIDIAN A&E GROUP

(SYNTHETIC SAMPLE)

CLIENT: ERICSSON

CARRIER: CARRIER-A

SITE ID: TXIR1340

SITE: VALLEY RANCH

9100 N MACARTHUR BLVD (SYN

IRVING, TX 75063

STRUCTURE: MONOPOLE

HEIGHT: 140 FT

REV 1 2026-08-23

ISSUED FOR CONSTRUCTION

NOT FOR CONSTRUCTION -

SYNTHETIC POC DATA

1 REVISE RAD CENTER OF EXISTING ANTENNAS 135 FT -> 130.7/130.8/130.9/131.2/131.4 FT (MEASURED).

ref DSC-B5BDB3BC44AA | was: [135.0] -> now: [130.7, 130.8, 130.9, 131.2, 131.4]

(E) EQUIPMENT CABINET

(P) HYBRID TRUNK - HORIZ RUN 35 FT

RAD CENTER 135'-0"

RAD CENTER 128'-0"


FINISHED GRADE 0'-0"

SHEET TITLE:

ELEVATION

SHEET A-2

N

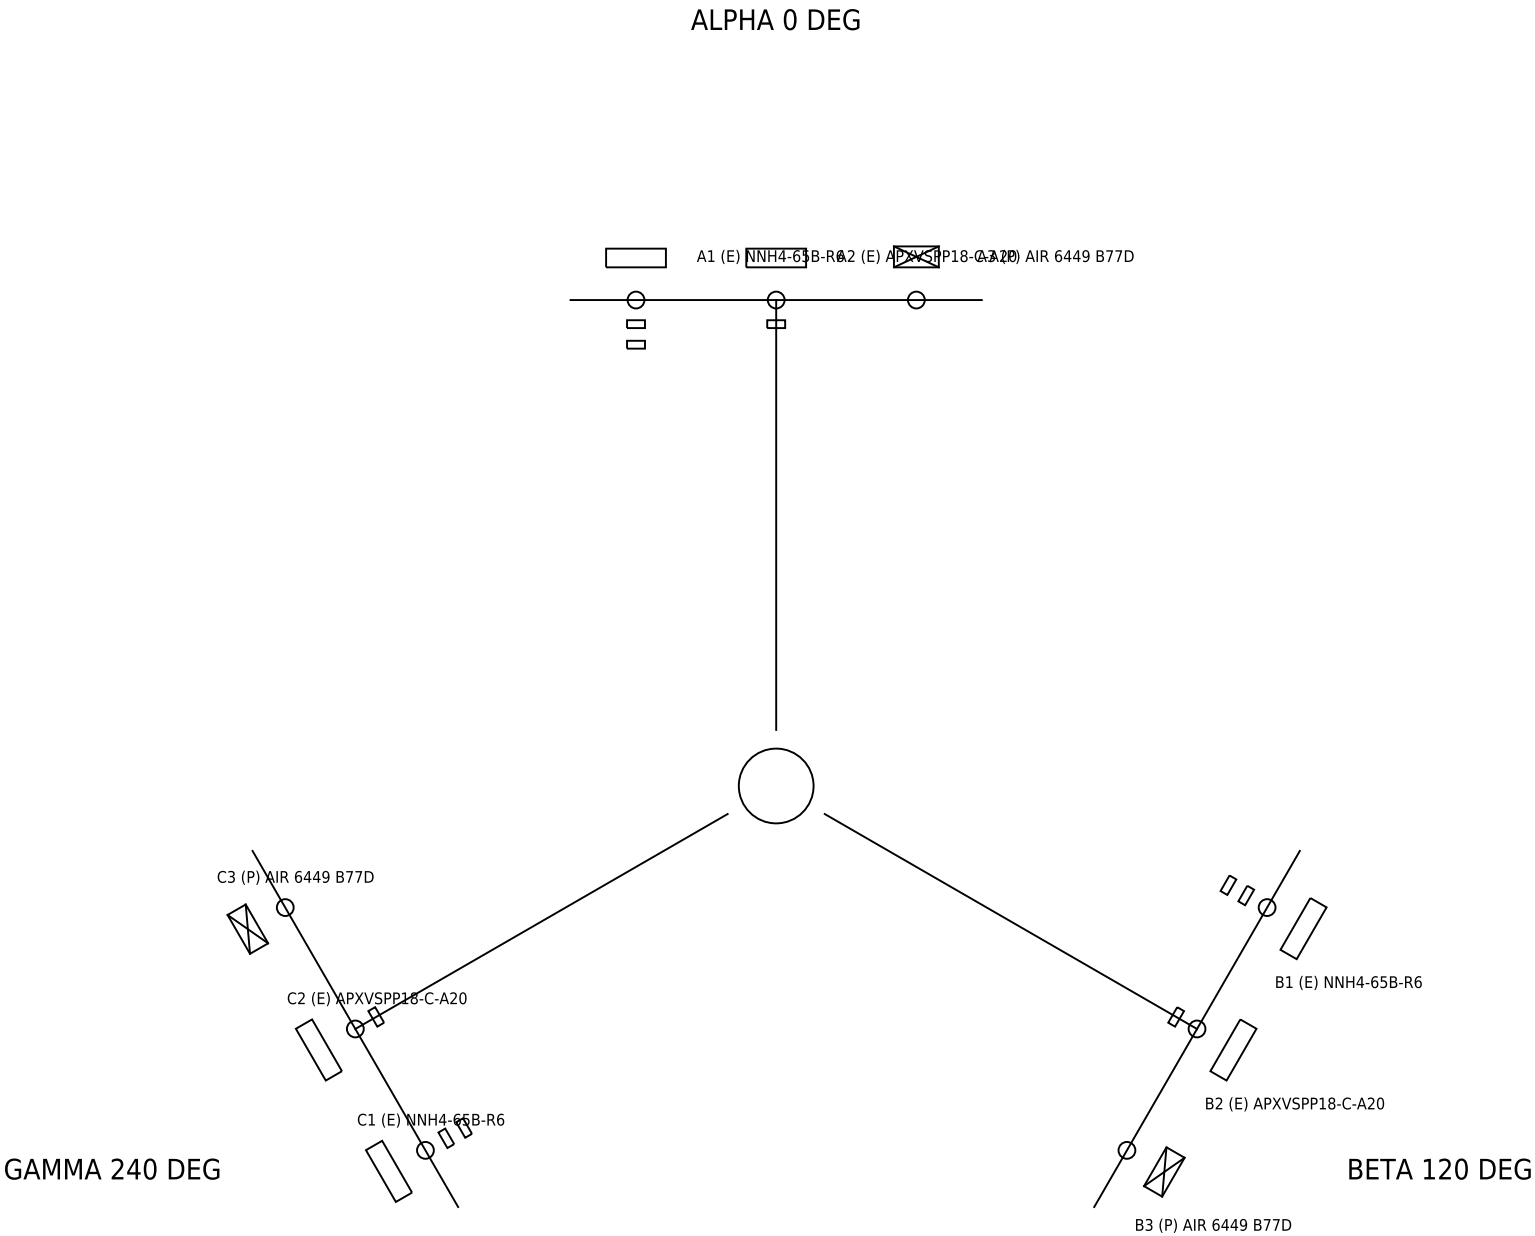

MERIDIAN A&E GROUP  
(SYNTHETIC SAMPLE)

CLIENT: ERICSSON  
CARRIER: CARRIER-A

SITE ID: TXIR1340  
SITE: VALLEY RANCH  
9100 N MACARTHUR BLVD (SYN  
IRVING, TX 75063

STRUCTURE: MONOPOLE  
HEIGHT: 140 FT

REV 1 2026-08-23  
ISSUED FOR CONSTRUCTION

NOT FOR CONSTRUCTION -  
SYNTHETIC POC DATA

SHEET TITLE:  
ANTENNA LAYOUT PLAN

SHEET A-3

ANTENNA & EQUIPMENT SCHEDULE

| SECTOR | AZ  | POS | STATUS   | TYPE    | MANUFACTURER | MODEL             | RC (FT) | M-TILT | BANDS  |
|--------|-----|-----|----------|---------|--------------|-------------------|---------|--------|--------|
| ALPHA  | 0   | 1   | EXISTING | ANTENNA | COMMSCOPE    | NNH4-65B-R6       | 135     | 0      | LB/MB  |
| ALPHA  | 0   | 1   | EXISTING | RRU     | ERICSSON     | RADIO 4449 B5 B12 | 135     | -      | B5/B12 |
| ALPHA  | 0   | 1   | EXISTING | RRU     | ERICSSON     | RADIO 4460 B2 B66 | 135     | -      | B2/B66 |
| ALPHA  | 0   | 2   | EXISTING | ANTENNA | RFS          | APXVSPP18-C-A20   | 135     | 0      | MB     |
| ALPHA  | 0   | 2   | EXISTING | RRU     | ERICSSON     | RADIO 2217 B66A   | 135     | -      | B66    |
| ALPHA  | 0   | 3   | PROPOSED | AAU     | ERICSSON     | AIR 6449 B77D     | 128     | 0      | n77    |
| BETA   | 120 | 1   | EXISTING | ANTENNA | COMMSCOPE    | NNH4-65B-R6       | 135     | 2      | LB/MB  |
| BETA   | 120 | 1   | EXISTING | RRU     | ERICSSON     | RADIO 4449 B5 B12 | 135     | -      | B5/B12 |
| BETA   | 120 | 1   | EXISTING | RRU     | ERICSSON     | RADIO 4460 B2 B66 | 135     | -      | B2/B66 |
| BETA   | 120 | 2   | EXISTING | ANTENNA | RFS          | APXVSPP18-C-A20   | 135     | 2      | MB     |
| BETA   | 120 | 2   | EXISTING | RRU     | ERICSSON     | RADIO 2217 B66A   | 135     | -      | B66    |
| BETA   | 120 | 3   | PROPOSED | AAU     | ERICSSON     | AIR 6449 B77D     | 128     | 1      | n77    |
| GAMMA  | 240 | 1   | EXISTING | ANTENNA | COMMSCOPE    | NNH4-65B-R6       | 135     | 2      | LB/MB  |
| GAMMA  | 240 | 1   | EXISTING | RRU     | ERICSSON     | RADIO 4449 B5 B12 | 135     | -      | B5/B12 |
| GAMMA  | 240 | 1   | EXISTING | RRU     | ERICSSON     | RADIO 4460 B2 B66 | 135     | -      | B2/B66 |
| GAMMA  | 240 | 2   | EXISTING | ANTENNA | RFS          | APXVSPP18-C-A20   | 135     | 1      | MB     |
| GAMMA  | 240 | 2   | EXISTING | RRU     | ERICSSON     | RADIO 2217 B66A   | 135     | -      | B66    |
| GAMMA  | 240 | 3   | PROPOSED | AAU     | ERICSSON     | AIR 6449 B77D     | 128     | 0      | n77    |

CABLE SCHEDULE (REQ'D = 1.10 x (VERT + HORIZ))

| TRUNK | TYPE        | FROM               | TO      | VERT (FT) | HORIZ (FT) | REQ'D (FT) | SPECIFIED |
|-------|-------------|--------------------|---------|-----------|------------|------------|-----------|
| T1    | HYBRID 6x12 | BASE OVP / CABINET | TOP OVP | 133       | 35         | 184.8      | 200 FT    |

JUMPER SCHEDULE

| JUMPER             | ROUTE          | LENGTH | QTY |
|--------------------|----------------|--------|-----|
| DC JUMPER 8 AWG    | TOP OVP TO RRU | 15 FT  | 0   |
| FIBER JUMPER LC-LC | TOP OVP TO RRU | 15 FT  | 0   |
| DC JUMPER 8 AWG    | TOP OVP TO AAU | 20 FT  | 3   |
| FIBER JUMPER LC-LC | TOP OVP TO AAU | 20 FT  | 3   |

MERIDIAN A&E GROUP  
(SYNTHETIC SAMPLE)

CLIENT: ERICSSON  
CARRIER: CARRIER-A


SITE ID: TXIR1340  
SITE: VALLEY RANCH  
9100 N MACARTHUR BLVD (SYN  
IRVING, TX 75063

STRUCTURE: MONOPOLE  
HEIGHT: 140 FT

REV 1 2026-08-23  
ISSUED FOR CONSTRUCTION

NOT FOR CONSTRUCTION -  
SYNTHETIC POC DATA

GROUNDING PLAN

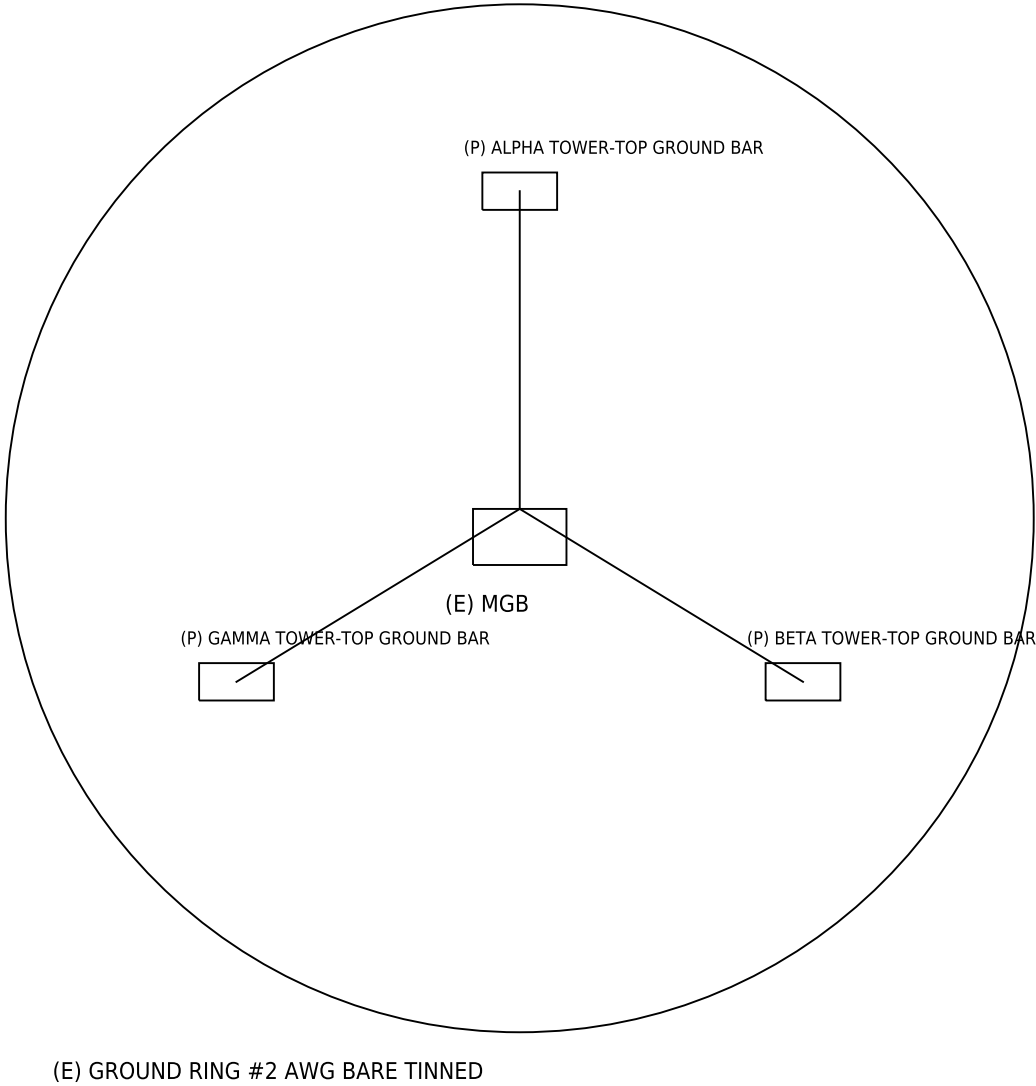

- 1. BOND EACH NEW RRU, AAU AND ANTENNA TO SECTOR GROUND BAR WITH #6 AWG.
- 2. GROUND HYBRID TRUNK AT TOP, BOTTOM AND MID-SPAN IF > 200 FT.
- 3. BOND TOP AND BASE OVP ENCLOSURES WITH #6 AWG.
- 4. ALL LUGS TWO-HOLE, TINNED, WITH ANTI-OXIDANT.

MERIDIAN A&E GROUP  
(SYNTHETIC SAMPLE)

CLIENT: ERICSSON  
CARRIER: CARRIER-A

SITE ID: TXIR1340  
SITE: VALLEY RANCH  
9100 N MACARTHUR BLVD (SYN  
IRVING, TX 75063

STRUCTURE: MONOPOLE  
HEIGHT: 140 FT

REV 1 2026-08-23  
ISSUED FOR CONSTRUCTION

NOT FOR CONSTRUCTION -  
SYNTHETIC POC DATA

SHEET TITLE:  
GROUNDING PLAN & NOTES

SHEET E-1