

REDLINE SUMMARY - TXMK1112 CD REV 1

ScopelQ - 2026-10-07 - 1 markup(s) - status per ScopelQ workflow

#	SHEET	MARKUP	FROM	TO	STATUS
1	A-3	ADD UNRECORDED (E) SBNHH-1D65B AT GAMMA POS 3 TO EXISTING INVENTORY AND MARK (R) REMOVE.	not shown	(E)/(R) SBNHH	DRAFT

CARRIER-A - FULL SITE MODERNIZATION

TXMK1112 LAKE FOREST

SCOPE OF WORK

- 1. INSTALL (3) NNH4-65B-R6
- 2. INSTALL (3) RADIO 4449 B5 B12
- 3. INSTALL (3) RADIO 4460 B2 B66
- 4. INSTALL (3) AIR 6449 B77D
- 5. INSTALL (3) AIR 6419 B41
- 6. REMOVE (3) SBNHH-1D65B
- 7. REMOVE (3) RRUS 11 B12
- 8. REMOVE (3) APXVSP18-C-A20
- 9. REMOVE (3) RADIO 2217 B66A
- 10. INSTALL (1) BASEBAND 6648 IN EXISTING CABINET
- 11. INSTALL (1) BASEBAND 6651 IN EXISTING CABINET
- 12. INSTALL (2) HYBRID TRUNK 6x12, 250 FT, WITH TOP AND BASE OVP
- 13. REPLACE EXISTING T-ARMS WITH NEW 12 FT SECTOR FRAMES
- 14. FIELD VERIFY ALL EXISTING CONDITIONS PRIOR TO CONSTRUCTION

SHEET INDEX

- T-1 TITLE SHEET & SCOPE OF WORK
- A-2 ELEVATION
- A-3 ANTENNA LAYOUT PLAN
- A-4 ANTENNA & CABLE SCHEDULE
- E-1 GROUNDING PLAN & NOTES

SITE INFORMATION

SITE ID: TXMK1112
SITE NAME: Lake Forest
MARKET: DFW
CUSTOMER: CARRIER-A
ADDRESS: 3300 Lake Forest Dr (synthetic)
CITY: McKinney
STATE: TX
ZIP: 75071
LATITUDE: 33.2178
LONGITUDE: -96.6743
STRUCTURE TYPE: Monopole
STRUCTURE HEIGHT (FT): 165
STRUCTURE OWNER: Lonestar Tower Partners
PROJECT TYPE: Full site modernization

GENERAL NOTES

CONTRACTOR SHALL VERIFY ALL DIMENSIONS AND EXISTING CONDITIONS BEFORE ORDERING MATERIAL.
ALL WORK PER CARRIER BUILD STANDARDS AND TIA-222-H.
RF CONFIGURATION PER RFDS R3.
MOUNT AND STRUCTURAL ADEQUACY PER MA/SA REPORTS.

MERIDIAN A&E GROUP
(SYNTHETIC SAMPLE)

CLIENT: ERICSSON
CARRIER: CARRIER-A

SITE ID: TXMK1112
SITE: LAKE FOREST
3300 LAKE FOREST DR (SYNTH
MCKINNEY, TX 75071

STRUCTURE: MONOPOLE
HEIGHT: 165 FT


REV 1 2026-08-29
ISSUED FOR CONSTRUCTION

NOT FOR CONSTRUCTION -
SYNTHETIC POC DATA

SHEET TITLE:
TITLE SHEET & SCOPE OF WORK

SHEET T-1

RAD CENTER 160'-0"

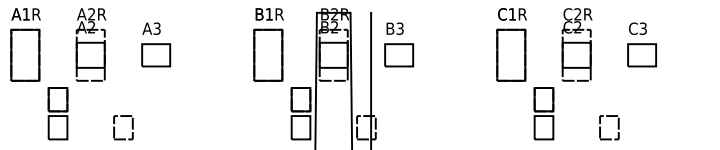

EQUIPMENT KEY

- A1R (R) SBNHH-1D65B RC 160'
- A2R (R) APXVSPP18-C-A20 RC 160'
- A1 (P) NNH4-65B-R6 RC 160'
- A2 (P) AIR 6449 B77D RC 160'
- A3 (P) AIR 6419 B41 RC 160'
- B1R (R) SBNHH-1D65B RC 160'
- B2R (R) APXVSPP18-C-A20 RC 160'
- B1 (P) NNH4-65B-R6 RC 160'
- B2 (P) AIR 6449 B77D RC 160'
- B3 (P) AIR 6419 B41 RC 160'
- C1R (R) SBNHH-1D65B RC 160'
- C2R (R) APXVSPP18-C-A20 RC 160'
- C1 (P) NNH4-65B-R6 RC 160'
- C2 (P) AIR 6449 B77D RC 160'
- C3 (P) AIR 6419 B41 RC 160'

FINISHED GRADE 0'-0"

(P) HYBRID TRUNK - HORIZ RUN 30 FT

(E) EQUIPMENT CABINET

MERIDIAN A&E GROUP
(SYNTHETIC SAMPLE)

CLIENT: ERICSSON
CARRIER: CARRIER-A

SITE ID: TXMK1112
SITE: LAKE FOREST
3300 LAKE FOREST DR (SYNTH
MCKINNEY, TX 75071

STRUCTURE: MONOPOLE
HEIGHT: 165 FT

REV 1 2026-08-29
ISSUED FOR CONSTRUCTION

NOT FOR CONSTRUCTION -
SYNTHETIC POC DATA

SHEET TITLE:
ELEVATION

SHEET A-2

N

REDLINE

ScopeIQ - 2026-10-07 - 1 markup(s) - status per ScopeIQ workflow

MERIDIAN A&E GROUP
(SYNTHETIC SAMPLE)

CLIENT: ERICSSON
CARRIER: CARRIER-A

SITE ID: TXMK1112
SITE: LAKE FOREST
3300 LAKE FOREST DR (SYNTH
MCKINNEY, TX 75071

STRUCTURE: MONOPOLE
HEIGHT: 165 FT

REV 1 2026-08-29
ISSUED FOR CONSTRUCTION

NOT FOR CONSTRUCTION -
SYNTHETIC POC DATA

ALPHA 20 DEG

GAMMA 260 DEG

BETA 140 DEG

1 ADD UNRECORDED (E) SBNHH-1D65B AT GAMMA POS 3 TO EXISTING INVENTORY AND MARK (R) REMOVE.
ref DSC-FAE2FB1B41FB | was: not shown -> now: (E)/(R) SBNHH

(E) EXISTING (P) PROPOSED (R) REMOVE. EQUIPMENT DATA HELD IN BLOCK ATTRIBUTES.

SHEET TITLE:
ANTENNA LAYOUT PLAN

SHEET A-3

ANTENNA & EQUIPMENT SCHEDULE

SECTOR	AZ	POS	STATUS	TYPE	MANUFACTURER	MODEL	RC (FT)	M-TILT	BANDS
ALPHA	20	1	REMOVE	ANTENNA	COMMSCOPE	SBNHH-1D65B	160	2	LB/MB
ALPHA	20	1	PROPOSED	ANTENNA	COMMSCOPE	NNH4-65B-R6	160	2	LB/MB
ALPHA	20	1	REMOVE	RRU	ERICSSON	RRUS 11 B12	160	-	B12
ALPHA	20	1	PROPOSED	RRU	ERICSSON	RADIO 4449 B5 B12	160	-	B5/B12
ALPHA	20	1	PROPOSED	RRU	ERICSSON	RADIO 4460 B2 B66	160	-	B2/B66
ALPHA	20	2	REMOVE	ANTENNA	RFS	APXVSP18-C-A20	160	0	MB
ALPHA	20	2	PROPOSED	AAU	ERICSSON	AIR 6449 B77D	160	0	n77
ALPHA	20	2	REMOVE	RRU	ERICSSON	RADIO 2217 B66A	160	-	B66
ALPHA	20	3	PROPOSED	AAU	ERICSSON	AIR 6419 B41	160	0	n41
BETA	140	1	REMOVE	ANTENNA	COMMSCOPE	SBNHH-1D65B	160	1	LB/MB
BETA	140	1	PROPOSED	ANTENNA	COMMSCOPE	NNH4-65B-R6	160	1	LB/MB
BETA	140	1	REMOVE	RRU	ERICSSON	RRUS 11 B12	160	-	B12
BETA	140	1	PROPOSED	RRU	ERICSSON	RADIO 4449 B5 B12	160	-	B5/B12
BETA	140	1	PROPOSED	RRU	ERICSSON	RADIO 4460 B2 B66	160	-	B2/B66
BETA	140	2	REMOVE	ANTENNA	RFS	APXVSP18-C-A20	160	0	MB
BETA	140	2	PROPOSED	AAU	ERICSSON	AIR 6449 B77D	160	0	n77
BETA	140	2	REMOVE	RRU	ERICSSON	RADIO 2217 B66A	160	-	B66
BETA	140	3	PROPOSED	AAU	ERICSSON	AIR 6419 B41	160	0	n41
GAMMA	260	1	REMOVE	ANTENNA	COMMSCOPE	SBNHH-1D65B	160	2	LB/MB
GAMMA	260	1	PROPOSED	ANTENNA	COMMSCOPE	NNH4-65B-R6	160	2	LB/MB
GAMMA	260	1	REMOVE	RRU	ERICSSON	RRUS 11 B12	160	-	B12
GAMMA	260	1	PROPOSED	RRU	ERICSSON	RADIO 4449 B5 B12	160	-	B5/B12
GAMMA	260	1	PROPOSED	RRU	ERICSSON	RADIO 4460 B2 B66	160	-	B2/B66
GAMMA	260	2	REMOVE	ANTENNA	RFS	APXVSP18-C-A20	160	2	MB
GAMMA	260	2	PROPOSED	AAU	ERICSSON	AIR 6449 B77D	160	2	n77
GAMMA	260	2	REMOVE	RRU	ERICSSON	RADIO 2217 B66A	160	-	B66
GAMMA	260	3	PROPOSED	AAU	ERICSSON	AIR 6419 B41	160	0	n41

CABLE SCHEDULE (REQ'D = 1.10 x (VERT + HORIZ))

TRUNK	TYPE	FROM	TO	VERT (FT)	HORIZ (FT)	REQ'D (FT)	SPECIFIED
T1	HYBRID 6x12	BASE OVP / CABINET	TOP OVP	165	30	214.5	250 FT
T2	HYBRID 6x12	BASE OVP / CABINET	TOP OVP	165	30	214.5	250 FT

JUMPER SCHEDULE

JUMPER	ROUTE	LENGTH	QTY
DC JUMPER 8 AWG	TOP OVP TO RRU	15 FT	6
FIBER JUMPER LC-LC	TOP OVP TO RRU	15 FT	6
DC JUMPER 8 AWG	TOP OVP TO AAU	20 FT	6
FIBER JUMPER LC-LC	TOP OVP TO AAU	20 FT	6

MERIDIAN A&E GROUP

(SYNTHETIC SAMPLE)

CLIENT: ERICSSON

CARRIER: CARRIER-A

SITE ID: TXMK1112

SITE: LAKE FOREST

3300 LAKE FOREST DR (SYNTH

MCKINNEY, TX 75071

STRUCTURE: MONOPOLE

HEIGHT: 165 FT

REV 1 2026-08-29

ISSUED FOR CONSTRUCTION

NOT FOR CONSTRUCTION -


SYNTHETIC POC DATA

SHEET TITLE:

ANTENNA & CABLE SCHEDULE

SHEET A-4

GROUNDING PLAN

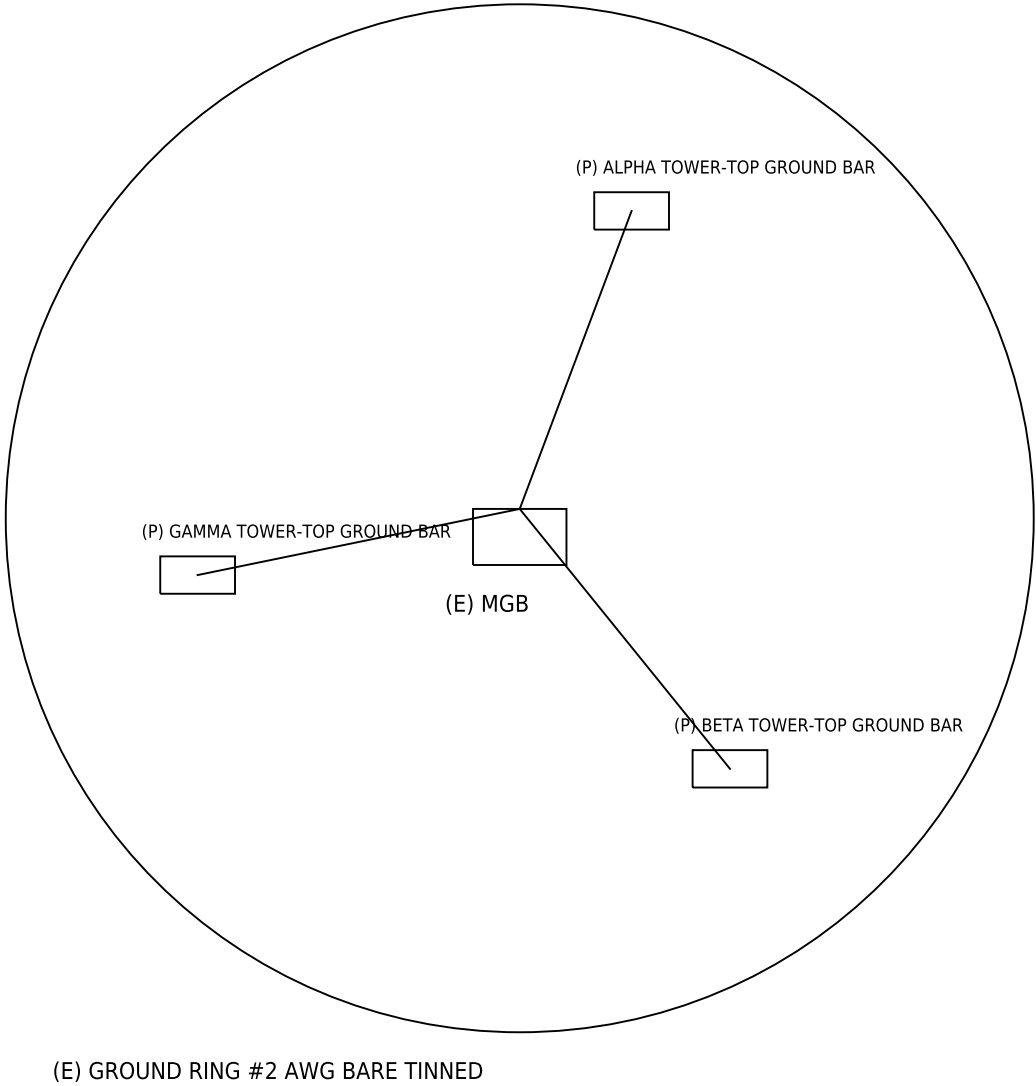

- 1. BOND EACH NEW RRU, AAU AND ANTENNA TO SECTOR GROUND BAR WITH #6 AWG.
- 2. GROUND HYBRID TRUNK AT TOP, BOTTOM AND MID-SPAN IF > 200 FT.
- 3. BOND TOP AND BASE OVP ENCLOSURES WITH #6 AWG.
- 4. ALL LUGS TWO-HOLE, TINNED, WITH ANTI-OXIDANT.

MERIDIAN A&E GROUP
(SYNTHETIC SAMPLE)

CLIENT: ERICSSON
CARRIER: CARRIER-A

SITE ID: TXMK1112
SITE: LAKE FOREST
3300 LAKE FOREST DR (SYNTH
MCKINNEY, TX 75071

STRUCTURE: MONOPOLE
HEIGHT: 165 FT

REV 1 2026-08-29
ISSUED FOR CONSTRUCTION

NOT FOR CONSTRUCTION -
SYNTHETIC POC DATA

SHEET TITLE:
GROUNDING PLAN & NOTES

SHEET E-1