

REDLINE SUMMARY - TXPL0588 CD REV 1

ScopelQ - 2026-10-07 - 2 markup(s) - status per ScopelQ workflow

#	SHEET	MARKUP	FROM	TO	STATUS
1	A-3	ADD MOUNT REINFORCEMENT PER MA-TXPL0588-R0: ALPHA MRK x1, BETA MRK x1, GAMMA MRK x1. ADD TO T-1 SCOPE OF WORK.	not shown	ALPHA MRK x1, BETA MRK	DRAFT
2	A-3	ADD UNRECORDED (E) RRUS 11 B12 AT GAMMA POS 1 TO EXISTING INVENTORY AND MARK (R) REMOVE.	not shown	(E)/(R) RRUS11	DRAFT

CARRIER-A - N41 ADD + LOW-BAND REFRESH

TXPL0588 LEGACY DRIVE

SCOPE OF WORK

- 1. INSTALL (3) NNH4-65B-R6
- 2. INSTALL (3) RADIO 4480 B71 B85
- 3. INSTALL (3) AIR 6419 B41
- 4. REMOVE (3) APXVSPP18-C-A20
- 5. REMOVE (3) RADIO 2217 B66A
- 6. INSTALL (1) BASEBAND 6651 IN EXISTING CABINET
- 7. INSTALL (1) HYBRID TRUNK 6x12, 200 FT, WITH TOP AND BASE OVP
- 8. FIELD VERIFY ALL EXISTING CONDITIONS PRIOR TO CONSTRUCTION

SHEET INDEX

- T-1 TITLE SHEET & SCOPE OF WORK
- A-2 ELEVATION
- A-3 ANTENNA LAYOUT PLAN
- A-4 ANTENNA & CABLE SCHEDULE
- E-1 GROUNDING PLAN & NOTES

SITE INFORMATION

SITE ID: TXPL0588
SITE NAME: Legacy Drive
MARKET: DFW
CUSTOMER: CARRIER-A
ADDRESS: 5800 Tennyson Pkwy (synthetic)
CITY: Plano
STATE: TX
ZIP: 75024
LATITUDE: 33.0768
LONGITUDE: -96.821
STRUCTURE TYPE: Monopole
STRUCTURE HEIGHT (FT): 125
STRUCTURE OWNER: Lonestar Tower Partners
PROJECT TYPE: n41 add + low-band refresh

GENERAL NOTES

CONTRACTOR SHALL VERIFY ALL DIMENSIONS AND EXISTING CONDITIONS BEFORE ORDERING MATERIAL.
ALL WORK PER CARRIER BUILD STANDARDS AND TIA-222-H.
RF CONFIGURATION PER RFDS R3.
MOUNT AND STRUCTURAL ADEQUACY PER MA/SA REPORTS.

MERIDIAN A&E GROUP
(SYNTHETIC SAMPLE)

CLIENT: ERICSSON
CARRIER: CARRIER-A

SITE ID: TXPL0588
SITE: LEGACY DRIVE
5800 TENNYSON PKWY (SYNTHE
PLANO, TX 75024

STRUCTURE: MONOPOLE
HEIGHT: 125 FT

REV 1 2026-08-22
ISSUED FOR CONSTRUCTION


NOT FOR CONSTRUCTION -
SYNTHETIC POC DATA

SHEET TITLE:
TITLE SHEET & SCOPE OF WORK

SHEET T-1

RAD CENTER 120'-0"

RAD CENTER 113'-0"

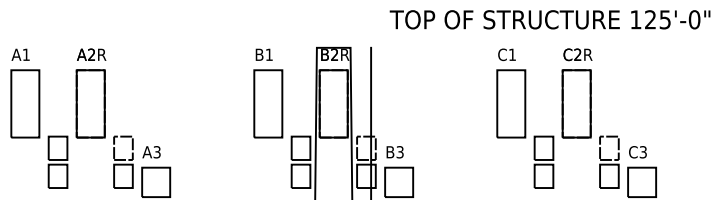

EQUIPMENT KEY

- A1 (E) NNH4-65B-R6 RC 120'
- A2R (R) APXVSPP18-C-A20 RC 120'
- A2 (P) NNH4-65B-R6 RC 120'
- A3 (P) AIR 6419 B41 RC 113'
- B1 (E) NNH4-65B-R6 RC 120'
- B2R (R) APXVSPP18-C-A20 RC 120'
- B2 (P) NNH4-65B-R6 RC 120'
- B3 (P) AIR 6419 B41 RC 113'
- C1 (E) NNH4-65B-R6 RC 120'
- C2R (R) APXVSPP18-C-A20 RC 120'
- C2 (P) NNH4-65B-R6 RC 120'
- C3 (P) AIR 6419 B41 RC 113'

FINISHED GRADE 0'-0"

(P) HYBRID TRUNK - HORIZ RUN 22 FT

(E) EQUIPMENT CABINET

MERIDIAN A&E GROUP

(SYNTHETIC SAMPLE)

CLIENT: ERICSSON

CARRIER: CARRIER-A

SITE ID: TXPL0588

SITE: LEGACY DRIVE

5800 TENNYSON PKWY (SYNTHE

PLANO, TX 75024

STRUCTURE: MONOPOLE

HEIGHT: 125 FT

REV 1 2026-08-22

ISSUED FOR CONSTRUCTION

NOT FOR CONSTRUCTION -

SYNTHETIC POC DATA

SHEET TITLE:

ELEVATION

SHEET A-2

N

REDLINE

ScopeIQ - 2026-10-07 - 2 markup(s) - status per ScopeIQ workflow

MERIDIAN A&E GROUP
(SYNTHETIC SAMPLE)

CLIENT: ERICSSON
CARRIER: CARRIER-A

SITE ID: TXPL0588
SITE: LEGACY DRIVE
5800 TENNYSON PKWY (SYNTHETIC)
PLANO, TX 75024

STRUCTURE: MONOPOLE
HEIGHT: 125 FT

REV 1 2026-08-22
ISSUED FOR CONSTRUCTION

NOT FOR CONSTRUCTION -
SYNTHETIC POC DATA

ALPHA 10 DEG

GAMMA 250 DEG

BETA 130 DEG

1 ADD MOUNT REINFORCEMENT PER MA-TXPL0588-R0: ALPHA MRK x1, BETA MRK x1, GAMMA MRK x1. ADD TO T-1 SCOPE OF WORK.
ref DSC-0C6EF257FBA2 | was: not shown -> now: ALPHA MRK x1, BETA MRK x1, GAMMA MRK

2 ADD UNRECORDED (E) RRUS 11 B12 AT GAMMA POS 1 TO EXISTING INVENTORY AND MARK (R) REMOVE.
ref DSC-72E4285C94EB | was: not shown -> now: (E)/(R) RRUS11

(E) EXISTING (P) PROPOSED (R) REMOVE. EQUIPMENT DATA HELD IN BLOCK ATTRIBUTES.

SHEET TITLE:
ANTENNA LAYOUT PLAN

SHEET A-3

ANTENNA & EQUIPMENT SCHEDULE

SECTOR	AZ	POS	STATUS	TYPE	MANUFACTURER	MODEL	RC (FT)	M-TILT	BANDS
ALPHA	10	1	EXISTING	ANTENNA	COMMSCOPE	NNH4-65B-R6	120	2	LB/MB
ALPHA	10	1	EXISTING	RRU	ERICSSON	RADIO 4449 B5 B12	120	-	B5/B12
ALPHA	10	1	EXISTING	RRU	ERICSSON	RADIO 4460 B2 B66	120	-	B2/B66
ALPHA	10	2	REMOVE	ANTENNA	RFS	APXVSP18-C-A20	120	0	MB
ALPHA	10	2	PROPOSED	ANTENNA	COMMSCOPE	NNH4-65B-R6	120	0	LB/MB
ALPHA	10	2	REMOVE	RRU	ERICSSON	RADIO 2217 B66A	120	-	B66
ALPHA	10	2	PROPOSED	RRU	ERICSSON	RADIO 4480 B71 B85	120	-	B71/B85
ALPHA	10	3	PROPOSED	AAU	ERICSSON	AIR 6419 B41	113	0	n41
BETA	130	1	EXISTING	ANTENNA	COMMSCOPE	NNH4-65B-R6	120	0	LB/MB
BETA	130	1	EXISTING	RRU	ERICSSON	RADIO 4449 B5 B12	120	-	B5/B12
BETA	130	1	EXISTING	RRU	ERICSSON	RADIO 4460 B2 B66	120	-	B2/B66
BETA	130	2	REMOVE	ANTENNA	RFS	APXVSP18-C-A20	120	0	MB
BETA	130	2	PROPOSED	ANTENNA	COMMSCOPE	NNH4-65B-R6	120	0	LB/MB
BETA	130	2	REMOVE	RRU	ERICSSON	RADIO 2217 B66A	120	-	B66
BETA	130	2	PROPOSED	RRU	ERICSSON	RADIO 4480 B71 B85	120	-	B71/B85
BETA	130	3	PROPOSED	AAU	ERICSSON	AIR 6419 B41	113	1	n41
GAMMA	250	1	EXISTING	ANTENNA	COMMSCOPE	NNH4-65B-R6	120	2	LB/MB
GAMMA	250	1	EXISTING	RRU	ERICSSON	RADIO 4449 B5 B12	120	-	B5/B12
GAMMA	250	1	EXISTING	RRU	ERICSSON	RADIO 4460 B2 B66	120	-	B2/B66
GAMMA	250	2	REMOVE	ANTENNA	RFS	APXVSP18-C-A20	120	0	MB
GAMMA	250	2	PROPOSED	ANTENNA	COMMSCOPE	NNH4-65B-R6	120	0	LB/MB
GAMMA	250	2	REMOVE	RRU	ERICSSON	RADIO 2217 B66A	120	-	B66
GAMMA	250	2	PROPOSED	RRU	ERICSSON	RADIO 4480 B71 B85	120	-	B71/B85
GAMMA	250	3	PROPOSED	AAU	ERICSSON	AIR 6419 B41	113	1	n41

CABLE SCHEDULE (REQ'D = 1.10 x (VERT + HORIZ))

TRUNK	TYPE	FROM	TO	VERT (FT)	HORIZ (FT)	REQ'D (FT)	SPECIFIED
T1	HYBRID 6x12	BASE OVP / CABINET	TOP OVP	125	22	161.7	200 FT

JUMPER SCHEDULE

JUMPER	ROUTE	LENGTH	QTY
DC JUMPER 8 AWG	TOP OVP TO RRU	15 FT	3
FIBER JUMPER LC-LC	TOP OVP TO RRU	15 FT	3
DC JUMPER 8 AWG	TOP OVP TO AAU	20 FT	3
FIBER JUMPER LC-LC	TOP OVP TO AAU	20 FT	3

MERIDIAN A&E GROUP

(SYNTHETIC SAMPLE)

CLIENT: ERICSSON

CARRIER: CARRIER-A

SITE ID: TXPL0588

SITE: LEGACY DRIVE

5800 TENNYSON PKWY (SYNTHE

PLANO, TX 75024

STRUCTURE: MONOPOLE

HEIGHT: 125 FT


REV 1 2026-08-22

ISSUED FOR CONSTRUCTION

NOT FOR CONSTRUCTION -

SYNTHETIC POC DATA

GROUNDING PLAN

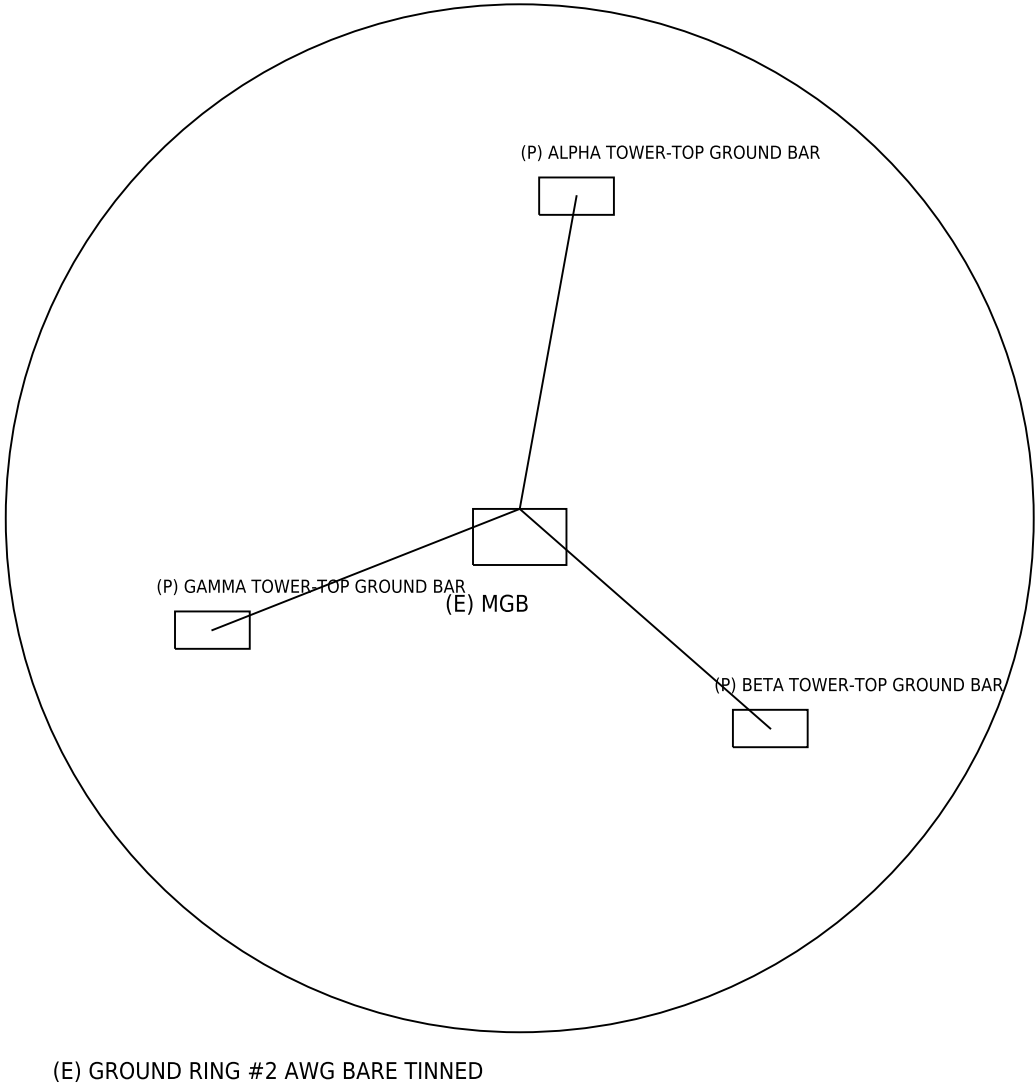

- 1. BOND EACH NEW RRU, AAU AND ANTENNA TO SECTOR GROUND BAR WITH #6 AWG.
- 2. GROUND HYBRID TRUNK AT TOP, BOTTOM AND MID-SPAN IF > 200 FT.
- 3. BOND TOP AND BASE OVP ENCLOSURES WITH #6 AWG.
- 4. ALL LUGS TWO-HOLE, TINNED, WITH ANTI-OXIDANT.

MERIDIAN A&E GROUP
(SYNTHETIC SAMPLE)

CLIENT: ERICSSON
CARRIER: CARRIER-A

SITE ID: TXPL0588
SITE: LEGACY DRIVE
5800 TENNYSON PKWY (SYNTHETIC)
PLANO, TX 75024

STRUCTURE: MONOPOLE
HEIGHT: 125 FT

REV 1 2026-08-22
ISSUED FOR CONSTRUCTION

NOT FOR CONSTRUCTION -
SYNTHETIC POC DATA

SHEET TITLE:
GROUNDING PLAN & NOTES

SHEET E-1