

REDLINE SUMMARY - TXRI0906 CD REV 1

ScopelQ - 2026-10-07 - 1 markup(s) - status per ScopelQ workflow

#	SHEET	MARKUP	FROM	TO	STATUS
1	A-3	(E) ROOF SLED AT DELTA NOT PRESENT PER DRONE SURVEY - REVISE TO (P) NON-PENETRATING ROOF SLED.	(E) roof sled	(P) roof sled	DRAFT

CARRIER-A - 5G C-BAND ADD + NEW SECTOR

TXRI0906 COLLINS TOWER

SCOPE OF WORK

- 1. INSTALL (4) AIR 6449 B77D
- 2. INSTALL (1) BASEBAND 6648 IN EXISTING CABINET
- 3. INSTALL (1) HYBRID TRUNK 6x12, 100 FT, WITH TOP AND BASE OVP
- 4. FIELD VERIFY ALL EXISTING CONDITIONS PRIOR TO CONSTRUCTION

SHEET INDEX

- T-1 TITLE SHEET & SCOPE OF WORK
- A-2 ELEVATION
- A-3 ANTENNA LAYOUT PLAN
- A-4 ANTENNA & CABLE SCHEDULE
- E-1 GROUNDING PLAN & NOTES

SITE INFORMATION

SITE ID: TXRI0906
SITE NAME: Collins Tower
MARKET: DFW
CUSTOMER: CARRIER-A
ADDRESS: 1300 E Collins Blvd (synthetic)
CITY: Richardson
STATE: TX
ZIP: 75080
LATITUDE: 32.9857
LONGITUDE: -96.7108
STRUCTURE TYPE: Rooftop
STRUCTURE HEIGHT (FT): 85
STRUCTURE OWNER: Collins Tower LLC (building owner)
PROJECT TYPE: 5G C-band add + new sector

GENERAL NOTES

CONTRACTOR SHALL VERIFY ALL DIMENSIONS AND EXISTING CONDITIONS BEFORE ORDERING MATERIAL.
ALL WORK PER CARRIER BUILD STANDARDS AND TIA-222-H.
RF CONFIGURATION PER RFDS R3.
MOUNT AND STRUCTURAL ADEQUACY PER MA/SA REPORTS.

MERIDIAN A&E GROUP
(SYNTHETIC SAMPLE)

CLIENT: ERICSSON
CARRIER: CARRIER-A

SITE ID: TXRI0906
SITE: COLLINS TOWER
1300 E COLLINS BLVD (SYNTH
RICHARDSON, TX 75080


STRUCTURE: ROOFTOP
HEIGHT: 85 FT

REV 1 2026-08-28
ISSUED FOR CONSTRUCTION

NOT FOR CONSTRUCTION -
SYNTHETIC POC DATA

SHEET TITLE:
TITLE SHEET & SCOPE OF WORK

SHEET T-1

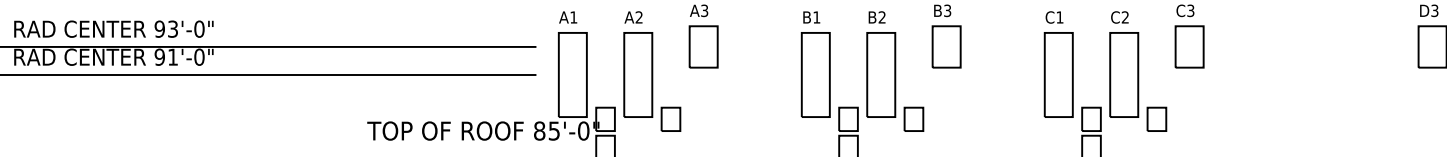

EQUIPMENT KEY

- A1 (E) NNH4-65B-R6 RC 91'
- A2 (E) APXVSPP18-C-A20 RC 91'
- A3 (P) AIR 6449 B77D RC 93'
- B1 (E) NNH4-65B-R6 RC 91'
- B2 (E) APXVSPP18-C-A20 RC 91'
- B3 (P) AIR 6449 B77D RC 93'
- C1 (E) NNH4-65B-R6 RC 91'
- C2 (E) APXVSPP18-C-A20 RC 91'
- C3 (P) AIR 6449 B77D RC 93'
- D3 (P) AIR 6449 B77D RC 93'

MERIDIAN A&E GROUP
(SYNTHETIC SAMPLE)

CLIENT: ERICSSON
CARRIER: CARRIER-A

SITE ID: TXRI0906
SITE: COLLINS TOWER
1300 E COLLINS BLVD (SYNTH
RICHARDSON, TX 75080

STRUCTURE: ROOFTOP
HEIGHT: 85 FT

REV 1 2026-08-28
ISSUED FOR CONSTRUCTION

NOT FOR CONSTRUCTION -
SYNTHETIC POC DATA

SHEET TITLE:
ELEVATION

SHEET A-2

REDLINE

ScopeIQ - 2026-10-07 - 1 markup(s) - status per ScopeIQ workflow

MERIDIAN A&E GROUP
(SYNTHETIC SAMPLE)


CLIENT: ERICSSON
CARRIER: CARRIER-A

SITE ID: TXRI0906
SITE: COLLINS TOWER
1300 E COLLINS BLVD (SYNTH
RICHARDSON, TX 75080

STRUCTURE: ROOFTOP
HEIGHT: 85 FT

REV 1 2026-08-28
ISSUED FOR CONSTRUCTION

NOT FOR CONSTRUCTION -
SYNTHETIC POC DATA

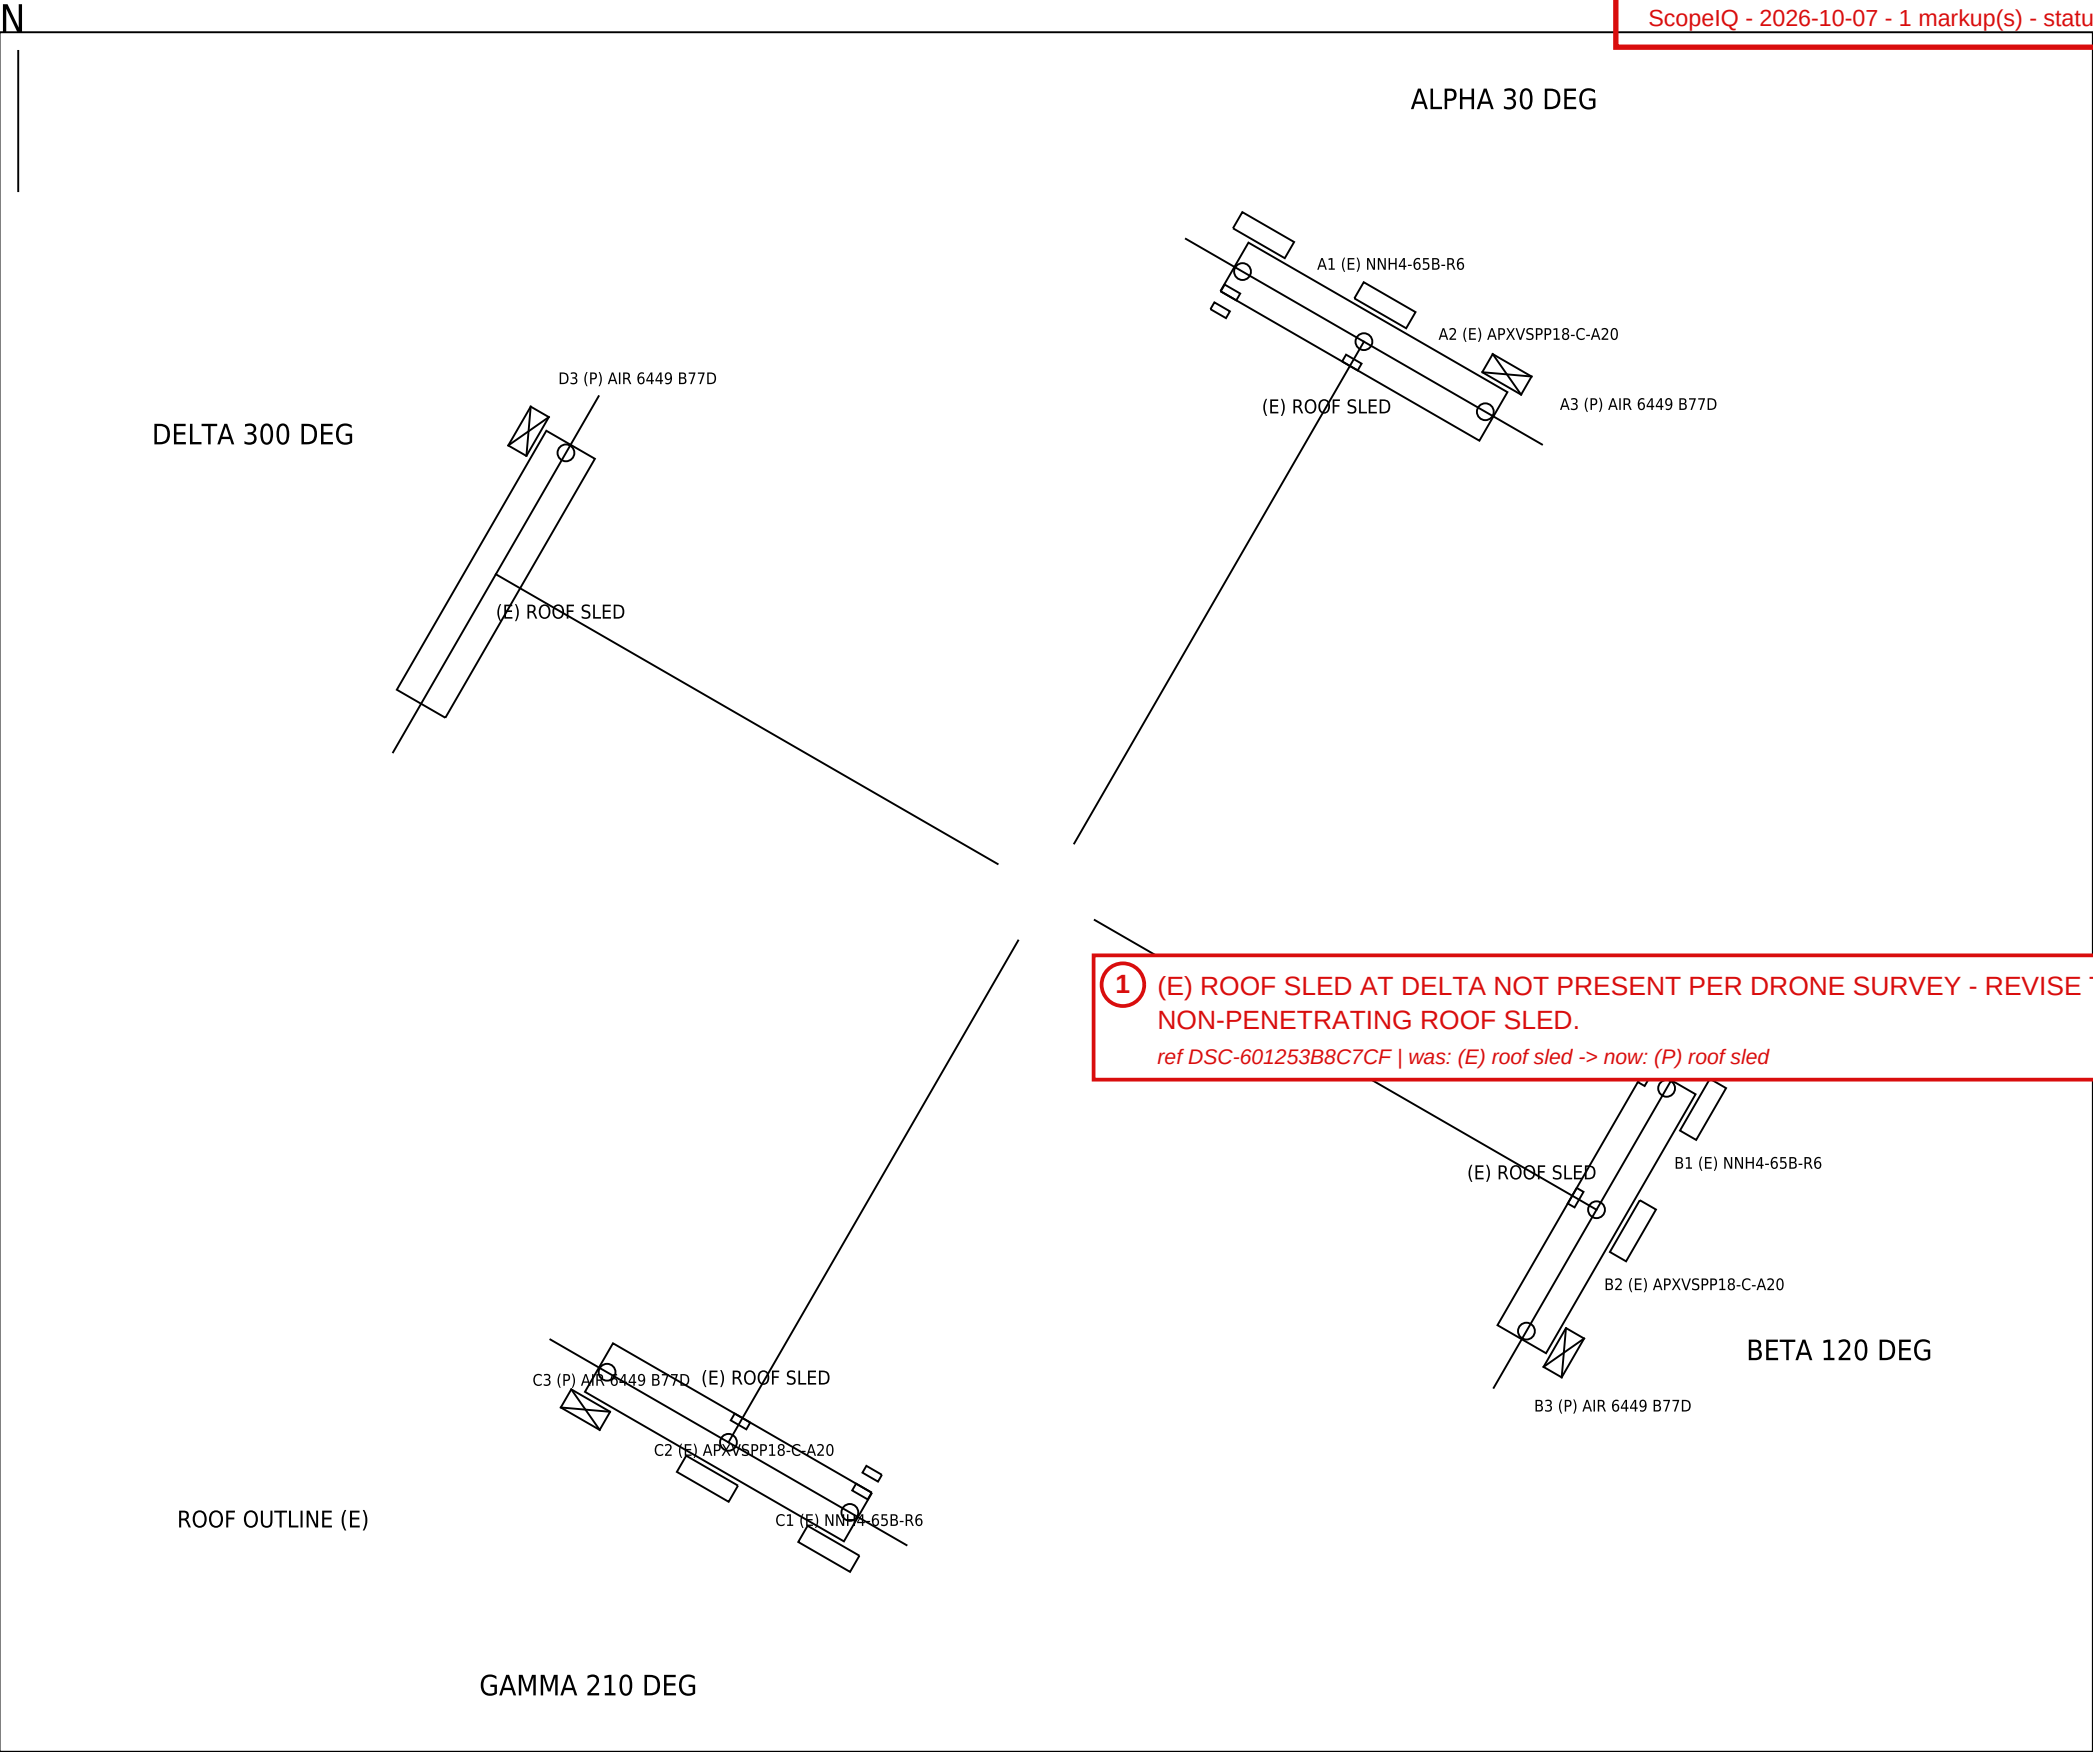

(E) EXISTING (P) PROPOSED (R) REMOVE. EQUIPMENT DATA HELD IN BLOCK ATTRIBUTES.

SHEET TITLE:
ANTENNA LAYOUT PLAN

SHEET A-3

ANTENNA & EQUIPMENT SCHEDULE

SECTOR	AZ	POS	STATUS	TYPE	MANUFACTURER	MODEL	RC (FT)	M-TILT	BANDS
ALPHA	30	1	EXISTING	ANTENNA	COMMSCOPE	NNH4-65B-R6	91	1	LB/MB
ALPHA	30	1	EXISTING	RRU	ERICSSON	RADIO 4449 B5 B12	91	-	B5/B12
ALPHA	30	1	EXISTING	RRU	ERICSSON	RADIO 4460 B2 B66	91	-	B2/B66
ALPHA	30	2	EXISTING	ANTENNA	RFS	APXVSP18-C-A20	91	1	MB
ALPHA	30	2	EXISTING	RRU	ERICSSON	RADIO 2217 B66A	91	-	B66
ALPHA	30	3	PROPOSED	AAU	ERICSSON	AIR 6449 B77D	93	2	n77
BETA	120	1	EXISTING	ANTENNA	COMMSCOPE	NNH4-65B-R6	91	2	LB/MB
BETA	120	1	EXISTING	RRU	ERICSSON	RADIO 4449 B5 B12	91	-	B5/B12
BETA	120	1	EXISTING	RRU	ERICSSON	RADIO 4460 B2 B66	91	-	B2/B66
BETA	120	2	EXISTING	ANTENNA	RFS	APXVSP18-C-A20	91	2	MB
BETA	120	2	EXISTING	RRU	ERICSSON	RADIO 2217 B66A	91	-	B66
BETA	120	3	PROPOSED	AAU	ERICSSON	AIR 6449 B77D	93	0	n77
GAMMA	210	1	EXISTING	ANTENNA	COMMSCOPE	NNH4-65B-R6	91	2	LB/MB
GAMMA	210	1	EXISTING	RRU	ERICSSON	RADIO 4449 B5 B12	91	-	B5/B12
GAMMA	210	1	EXISTING	RRU	ERICSSON	RADIO 4460 B2 B66	91	-	B2/B66
GAMMA	210	2	EXISTING	ANTENNA	RFS	APXVSP18-C-A20	91	2	MB
GAMMA	210	2	EXISTING	RRU	ERICSSON	RADIO 2217 B66A	91	-	B66
GAMMA	210	3	PROPOSED	AAU	ERICSSON	AIR 6449 B77D	93	1	n77
DELTA	300	3	PROPOSED	AAU	ERICSSON	AIR 6449 B77D	93	1	n77

CABLE SCHEDULE (REQ'D = 1.10 x (VERT + HORIZ))

TRUNK	TYPE	FROM	TO	VERT (FT)	HORIZ (FT)	REQ'D (FT)	SPECIFIED
T1	HYBRID 6x12	BASE OVP / CABINET	TOP OVP	10	60	77.0	100 FT

JUMPER SCHEDULE

JUMPER	ROUTE	LENGTH	QTY
DC JUMPER 8 AWG	TOP OVP TO RRU	15 FT	0
FIBER JUMPER LC-LC	TOP OVP TO RRU	15 FT	0
DC JUMPER 8 AWG	TOP OVP TO AAU	20 FT	4
FIBER JUMPER LC-LC	TOP OVP TO AAU	20 FT	4

MERIDIAN A&E GROUP

(SYNTHETIC SAMPLE)

CLIENT: ERICSSON

CARRIER: CARRIER-A

SITE ID: TXRI0906

SITE: COLLINS TOWER

1300 E COLLINS BLVD (SYNTH

RICHARDSON, TX 75080

STRUCTURE: ROOFTOP

HEIGHT: 85 FT

REV 1 2026-08-28

ISSUED FOR CONSTRUCTION

NOT FOR CONSTRUCTION -


SYNTHETIC POC DATA

SHEET TITLE:

ANTENNA & CABLE SCHEDULE

SHEET A-4

GROUNDING PLAN

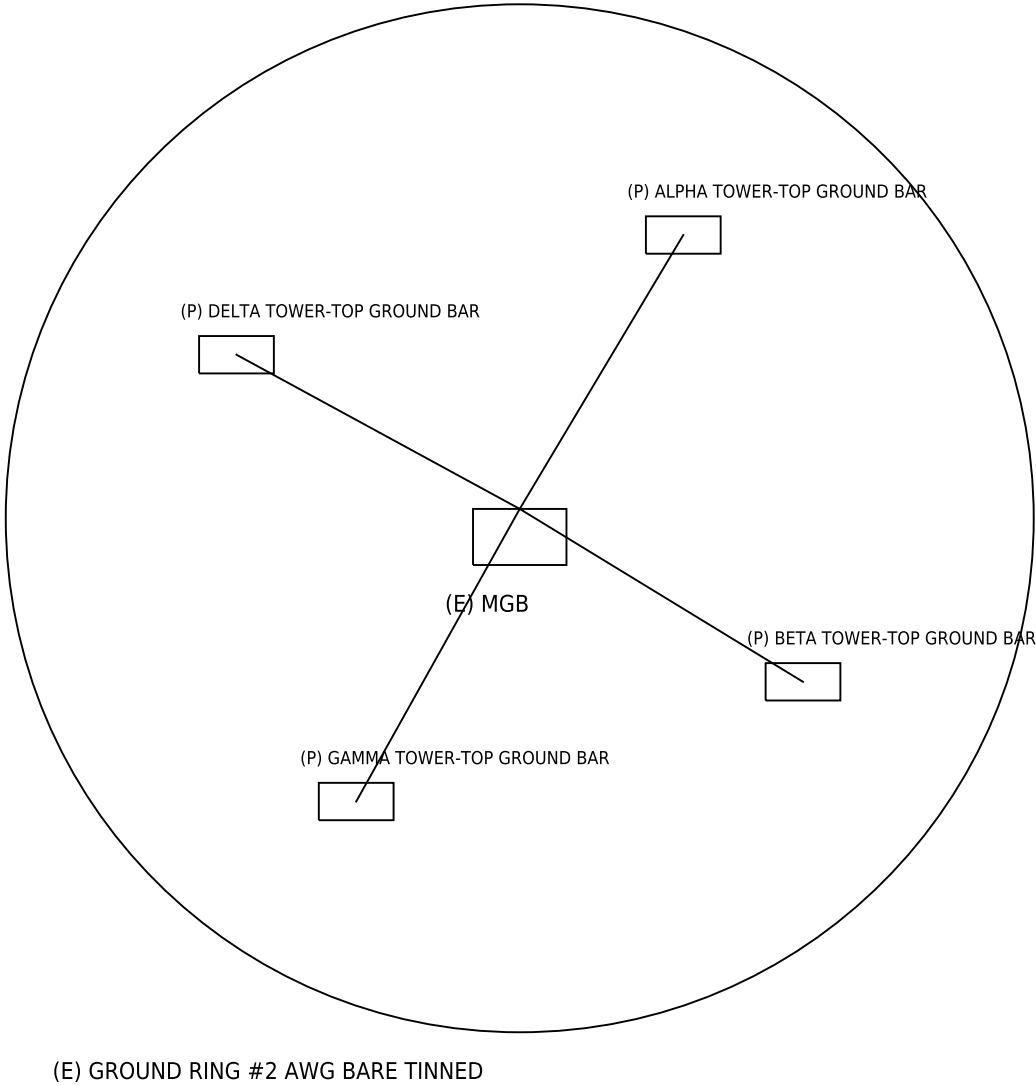

- 1. BOND EACH NEW RRU, AAU AND ANTENNA TO SECTOR GROUND BAR WITH #6 AWG.
- 2. GROUND HYBRID TRUNK AT TOP, BOTTOM AND MID-SPAN IF > 200 FT.
- 3. BOND TOP AND BASE OVP ENCLOSURES WITH #6 AWG.
- 4. ALL LUGS TWO-HOLE, TINNED, WITH ANTI-OXIDANT.

MERIDIAN A&E GROUP
(SYNTHETIC SAMPLE)

CLIENT: ERICSSON
CARRIER: CARRIER-A

SITE ID: TXRI0906
SITE: COLLINS TOWER
1300 E COLLINS BLVD (SYNTH
RICHARDSON, TX 75080

STRUCTURE: ROOFTOP
HEIGHT: 85 FT

REV 1 2026-08-28
ISSUED FOR CONSTRUCTION

NOT FOR CONSTRUCTION -
SYNTHETIC POC DATA

SHEET TITLE:
GROUNDING PLAN & NOTES

SHEET E-1