

REDLINE SUMMARY - TXAD0405 CD REV 1

ScopelQ - 2026-10-08 - 2 markup(s) - status per ScopelQ workflow

#	SHEET	MARKUP	FROM	TO	STATUS
1	A-3	REVISE BETA POSITIONS PER RFDS R3: RADIO 4480 B71 B85 TO POS 2; NNH4-65B-R6 TO POS 1/2; AIR 6419 B41 TO POS 3.	RADIO 4480 B71 B85 pos 3	RADIO 4480 B71 B85 pos	DRAFT
2	A-2	REVISE RAD CENTER OF EXISTING ANTENNAS 63 FT -> 67.9 FT (MEASURED).	63 ft	67.9 ft	DRAFT

CARRIER-A - N41 ADD + LOW-BAND REFRESH

TXAD0405 UPTOWN PLAZA

SCOPE OF WORK

- 1. INSTALL (2) NNH4-65B-R6
- 2. INSTALL (2) RADIO 4480 B71 B85
- 3. INSTALL (2) AIR 6419 B41
- 4. REMOVE (2) APXVSPP18-C-A20
- 5. REMOVE (2) RADIO 2217 B66A
- 6. INSTALL (1) BASEBAND 6651 IN EXISTING CABINET
- 7. INSTALL (1) HYBRID TRUNK 6x12, 100 FT, WITH TOP AND BASE OVP
- 8. FIELD VERIFY ALL EXISTING CONDITIONS PRIOR TO CONSTRUCTION

SHEET INDEX

- T-1 TITLE SHEET & SCOPE OF WORK
- A-2 ELEVATION
- A-3 ANTENNA LAYOUT PLAN
- A-4 ANTENNA & CABLE SCHEDULE
- E-1 GROUNDING PLAN & NOTES

SITE INFORMATION

SITE ID: TXAD0405
SITE NAME: Uptown Plaza
MARKET: DFW
CUSTOMER: CARRIER-A
ADDRESS: 15600 Dallas Pkwy (synthetic)
CITY: Addison
STATE: TX
ZIP: 75001
LATITUDE: 32.9587
LONGITUDE: -96.8295
STRUCTURE TYPE: Rooftop
STRUCTURE HEIGHT (FT): 60
STRUCTURE OWNER: Uptown Plaza Holdings (building owner)
PROJECT TYPE: n41 add + low-band refresh

GENERAL NOTES

CONTRACTOR SHALL VERIFY ALL DIMENSIONS AND EXISTING CONDITIONS BEFORE ORDERING MATERIAL.
ALL WORK PER CARRIER BUILD STANDARDS AND TIA-222-H.
RF CONFIGURATION PER RFDS R3.
MOUNT AND STRUCTURAL ADEQUACY PER MA/SA REPORTS.

MERIDIAN A&E GROUP
(SYNTHETIC SAMPLE)

CLIENT: ERICSSON
CARRIER: CARRIER-A

SITE ID: TXAD0405
SITE: UPTOWN PLAZA
15600 DALLAS PKWY (SYNTHETIC)
ADDISON, TX 75001

STRUCTURE: ROOFTOP
HEIGHT: 60 FT

REV 1 2026-08-30
ISSUED FOR CONSTRUCTION

NOT FOR CONSTRUCTION -
SYNTHETIC POC DATA

SHEET TITLE:
TITLE SHEET & SCOPE OF WORK

SHEET T-1

REDLINE

EQUIPMENT KEY

ScopeIQ - 2026-10-08 - 2 markup(s) - status per ScopeIQ workflow

A1 (E) NNH4-65B-R6 RC 63'

A2R (R) APXVSPP18-C-A20 RC 63'

A2 (P) NNH4-65B-R6 RC 63'

A3 (P) AIR 6419 B41 RC 68'

B1 (E) NNH4-65B-R6 RC 63'

B2R (R) APXVSPP18-C-A20 RC 63'

B3 (P) NNH4-65B-R6 RC 63'

B2 (P) AIR 6419 B41 RC 68'

MERIDIAN A&E GROUP

(SYNTHETIC SAMPLE)

CLIENT: ERICSSON

CARRIER: CARRIER-A

SITE ID: TXAD0405

SITE: UPTOWN PLAZA

15600 DALLAS PKWY (SYNTHET

ADDISON, TX 75001

STRUCTURE: ROOFTOP

HEIGHT: 60 FT

REV 1 2026-08-30

ISSUED FOR CONSTRUCTION

NOT FOR CONSTRUCTION -

SYNTHETIC POC DATA

SHEET TITLE:

ELEVATION

SHEET A-2

RAD CENTER 68'-0"


RAD CENTER 63'-0"

TOP OF ROOF 60'-0"

FINISHED GRADE 0'-0"

2 REVISE RAD CENTER OF EXISTING ANTENNAS 63 FT -> 67.9 FT (MEASURED).

ref DSC-5A99342D3F40 | was: 63 ft -> now: 67.9 ft

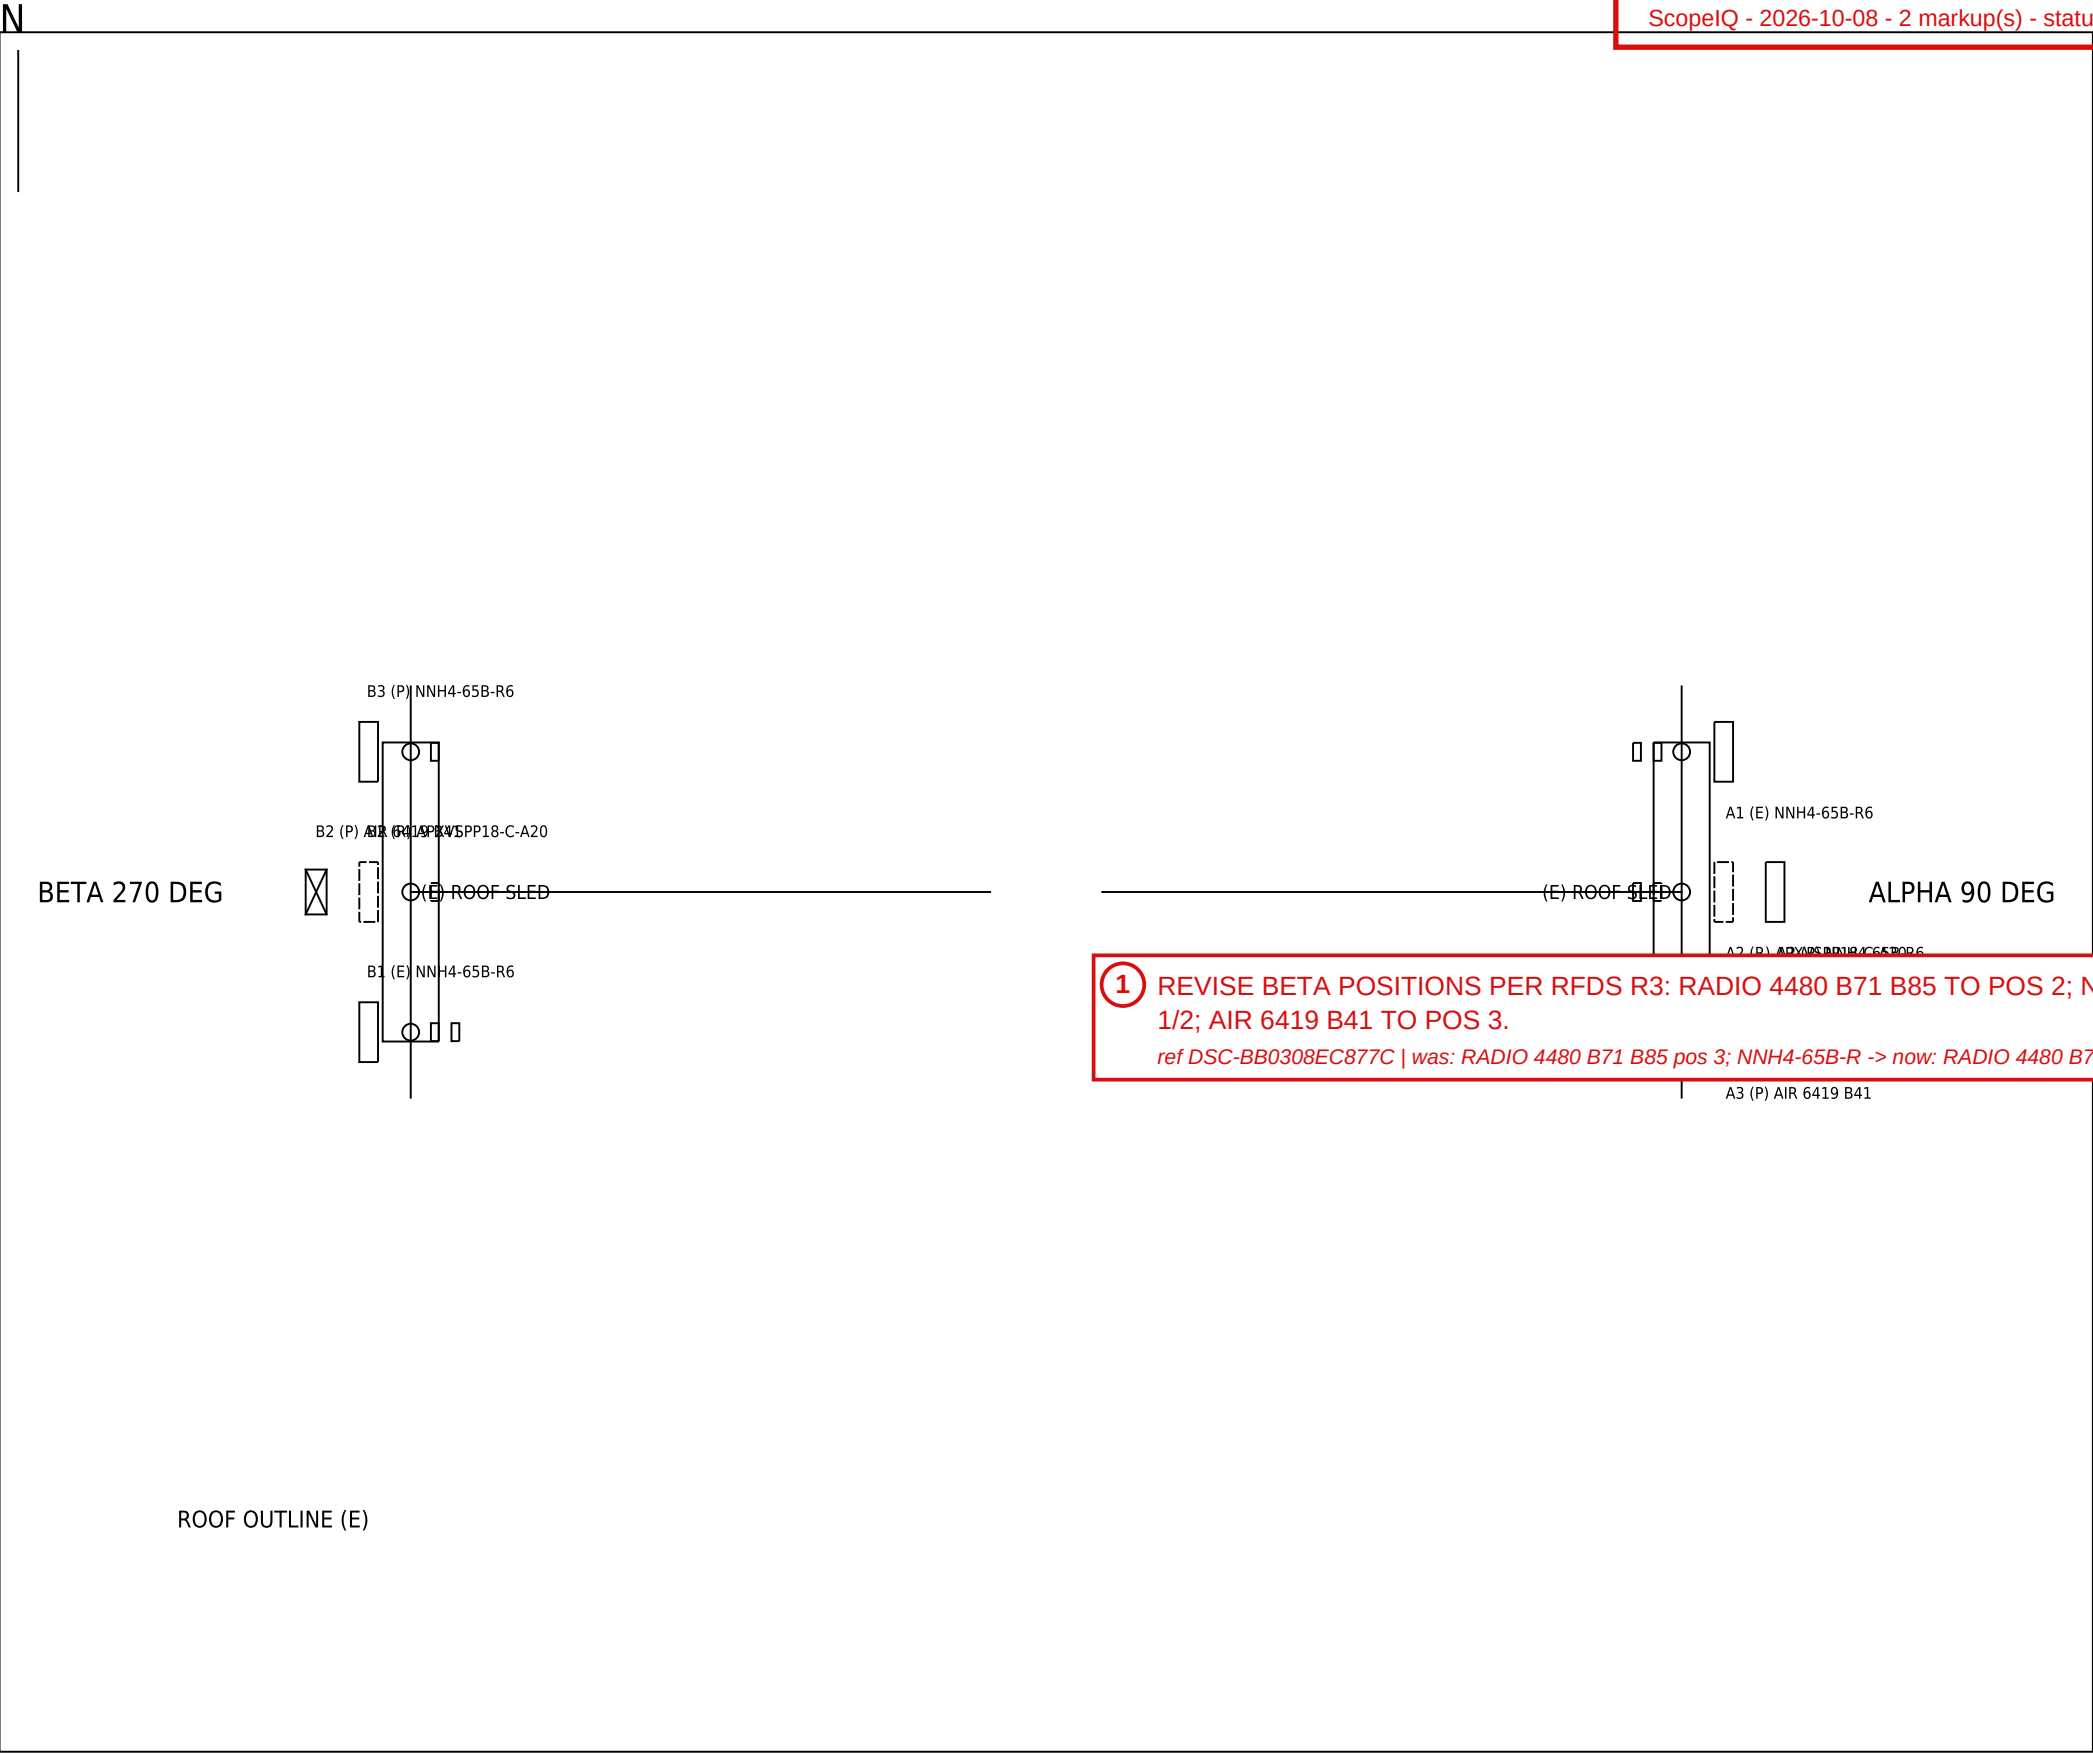

REDLINE

ScopeIQ - 2026-10-08 - 2 markup(s) - status per ScopeIQ workflow

MERIDIAN A&E GROUP
(SYNTHETIC SAMPLE)

CLIENT: ERICSSON
CARRIER: CARRIER-A

SITE ID: TXAD0405
SITE: UPTOWN PLAZA
15600 DALLAS PKWY (SYNTHET
ADDISON, TX 75001

STRUCTURE: ROOFTOP
HEIGHT: 60 FT

REV 1 2026-08-30
ISSUED FOR CONSTRUCTION

NOT FOR CONSTRUCTION -
SYNTHETIC POC DATA

SHEET TITLE:
ANTENNA LAYOUT PLAN

SHEET A-3

(E) EXISTING (P) PROPOSED (R) REMOVE. EQUIPMENT DATA HELD IN BLOCK ATTRIBUTES.

ANTENNA & EQUIPMENT SCHEDULE

SECTOR	AZ	POS	STATUS	TYPE	MANUFACTURER	MODEL	RC (FT)	M-TILT	BANDS
ALPHA	90	1	EXISTING	ANTENNA	COMMSCOPE	NNH4-65B-R6	63	1	LB/MB
ALPHA	90	1	EXISTING	RRU	ERICSSON	RADIO 4449 B5 B12	63	-	B5/B12
ALPHA	90	1	EXISTING	RRU	ERICSSON	RADIO 4460 B2 B66	63	-	B2/B66
ALPHA	90	2	REMOVE	ANTENNA	RFS	APXVSP18-C-A20	63	2	MB
ALPHA	90	2	PROPOSED	ANTENNA	COMMSCOPE	NNH4-65B-R6	63	2	LB/MB
ALPHA	90	2	REMOVE	RRU	ERICSSON	RADIO 2217 B66A	63	-	B66
ALPHA	90	2	PROPOSED	RRU	ERICSSON	RADIO 4480 B71 B85	63	-	B71/B85
ALPHA	90	3	PROPOSED	AAU	ERICSSON	AIR 6419 B41	68	1	n41
BETA	270	1	EXISTING	ANTENNA	COMMSCOPE	NNH4-65B-R6	63	0	LB/MB
BETA	270	1	EXISTING	RRU	ERICSSON	RADIO 4449 B5 B12	63	-	B5/B12
BETA	270	1	EXISTING	RRU	ERICSSON	RADIO 4460 B2 B66	63	-	B2/B66
BETA	270	2	REMOVE	ANTENNA	RFS	APXVSP18-C-A20	63	1	MB
BETA	270	2	PROPOSED	AAU	ERICSSON	AIR 6419 B41	68	0	n41
BETA	270	2	REMOVE	RRU	ERICSSON	RADIO 2217 B66A	63	-	B66
BETA	270	3	PROPOSED	ANTENNA	COMMSCOPE	NNH4-65B-R6	63	1	LB/MB
BETA	270	3	PROPOSED	RRU	ERICSSON	RADIO 4480 B71 B85	63	-	B71/B85

CABLE SCHEDULE (REQ'D = 1.10 x (VERT + HORIZ))

TRUNK	TYPE	FROM	TO	VERT (FT)	HORIZ (FT)	REQ'D (FT)	SPECIFIED
T1	HYBRID 6x12	BASE OVP / CABINET	TOP OVP	10	45	60.5	100 FT

JUMPER SCHEDULE

JUMPER	ROUTE	LENGTH	QTY
DC JUMPER 8 AWG	TOP OVP TO RRU	15 FT	2
FIBER JUMPER LC-LC	TOP OVP TO RRU	15 FT	2
DC JUMPER 8 AWG	TOP OVP TO AAU	20 FT	2
FIBER JUMPER LC-LC	TOP OVP TO AAU	20 FT	2

MERIDIAN A&E GROUP

(SYNTHETIC SAMPLE)

CLIENT: ERICSSON

CARRIER: CARRIER-A

SITE ID: TXAD0405

SITE: UPTOWN PLAZA

15600 DALLAS PKWY (SYNTHETIC)

ADDISON, TX 75001

STRUCTURE: ROOFTOP

HEIGHT: 60 FT

REV 1 2026-08-30

ISSUED FOR CONSTRUCTION

NOT FOR CONSTRUCTION -

SYNTHETIC POC DATA

GROUNDING PLAN



- 1. BOND EACH NEW RRU, AAU AND ANTENNA TO SECTOR GROUND BAR WITH #6 AWG.
- 2. GROUND HYBRID TRUNK AT TOP, BOTTOM AND MID-SPAN IF > 200 FT.
- 3. BOND TOP AND BASE OVP ENCLOSURES WITH #6 AWG.
- 4. ALL LUGS TWO-HOLE, TINNED, WITH ANTI-OXIDANT.

MERIDIAN A&E GROUP
(SYNTHETIC SAMPLE)

CLIENT: ERICSSON
CARRIER: CARRIER-A

SITE ID: TXAD0405
SITE: UPTOWN PLAZA
15600 DALLAS PKWY (SYNTHET
ADDISON, TX 75001

STRUCTURE: ROOFTOP
HEIGHT: 60 FT

REV 1 2026-08-30
ISSUED FOR CONSTRUCTION

NOT FOR CONSTRUCTION -
SYNTHETIC POC DATA

SHEET TITLE:
GROUNDING PLAN & NOTES

SHEET E-1