REDLINE SUMMARY - TXDA1024 CD REV 1

ScopeIQ - 2026-10-28 - 1 markup(s) on TXDA1024_CD_REV1.dxf - status per ScopeIQ workflow

#	SHEET	MARKUP	FROM	TO	STATUS
1	A-3	DELETE (E) SPARE PIPE AT BETA POS 3 - NOT PRESENT PER DRONE SURVEY. ADD (P) MOUNT PIPE IF POSITION IS USED.	(E) pipe	none / (P) pipe	DRAFT

CARRIER-A - 5G C-BAND ADD

TXDA1024 LAKEWOOD HEIGHTS

SCOPE OF WORK

1. INSTALL (3) AIR 6449 B77D
2. INSTALL (1) BASEBAND 6648 IN EXISTING CABINET
3. INSTALL (1) HYBRID TRUNK 6x12, 200 FT, WITH TOP AND BASE OVP
4. FIELD VERIFY ALL EXISTING CONDITIONS PRIOR TO CONSTRUCTION

SHEET INDEX

T-1 TITLE SHEET & SCOPE OF WORK
A-2 ELEVATION
A-3 ANTENNA LAYOUT PLAN
A-4 ANTENNA & CABLE SCHEDULE
E-1 GROUNDING PLAN & NOTES

SITE INFORMATION

SITE ID: TXDA1024
SITE NAME: Lakewood Heights
MARKET: DFW
CUSTOMER: CARRIER-A
ADDRESS: 6120 Abrams Rd (synthetic)
CITY: Dallas
STATE: TX
ZIP: 75214
LATITUDE: 32.8341
LONGITUDE: -96.7512
STRUCTURE TYPE: Monopole
STRUCTURE HEIGHT (FT): 150
STRUCTURE OWNER: Lonestar Tower Partners
PROJECT TYPE: 5G C-band add

GENERAL NOTES

CONTRACTOR SHALL VERIFY ALL DIMENSIONS AND EXISTING CONDITIONS BEFORE ORDERING MATERIAL.
ALL WORK PER CARRIER BUILD STANDARDS AND TIA-222-H.
RF CONFIGURATION PER RFDS R3.
MOUNT AND STRUCTURAL ADEQUACY PER MA/SA REPORTS.

MERIDIAN A&E GROUP
(SYNTHETIC SAMPLE)

CLIENT: ERICSSON
CARRIER: CARRIER-A

SITE ID: TXDA1024
SITE: LAKEWOOD HEIGHTS
6120 ABRAMS RD (SYNTHETIC)
DALLAS, TX 75214


STRUCTURE: MONOPOLE
HEIGHT: 150 FT

REV 1 2026-08-20
ISSUED FOR CONSTRUCTION

NOT FOR CONSTRUCTION - SYNTHETIC POC DATA

SHEET TITLE:
TITLE SHEET & SCOPE OF WORK

SHEET T-1

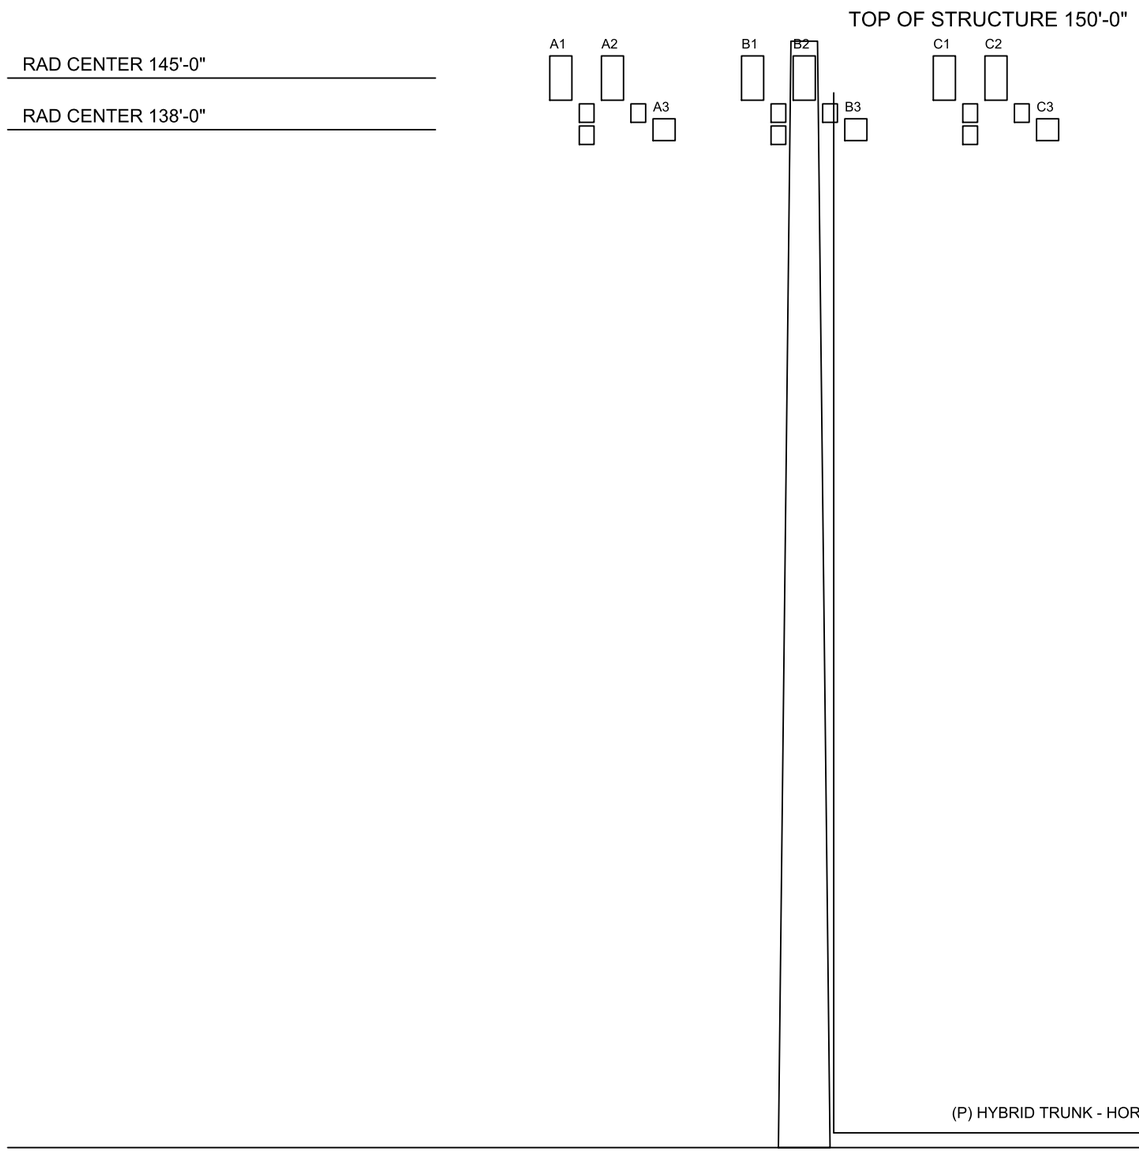

EQUIPMENT KEY

A1 (E) NNH4-65B-R6 RC 145'

A2 (E) APXVSPP18-C-A20 RC 145'

A3 (P) AIR 6449 B77D RC 138'

B1 (E) NNH4-65B-R6 RC 145'

B2 (E) APXVSPP18-C-A20 RC 145'

B3 (P) AIR 6449 B77D RC 138'

C1 (E) NNH4-65B-R6 RC 145'

C2 (E) APXVSPP18-C-A20 RC 145'

C3 (P) AIR 6449 B77D RC 138'

MERIDIAN A&E GROUP

(SYNTHETIC SAMPLE)

CLIENT: ERICSSON

CARRIER: CARRIER-A

SITE ID: TXDA1024

SITE: LAKEWOOD HEIGHTS

6120 ABRAMS RD (SYNTHETIC)

DALLAS, TX 75214

STRUCTURE: MONOPOLE

HEIGHT: 150 FT

REV 1 2026-08-20

ISSUED FOR CONSTRUCTION

NOT FOR CONSTRUCTION -

SYNTHETIC POC DATA


SHEET TITLE:

ELEVATION

SHEET A-2

N

ALPHA 0 DEG

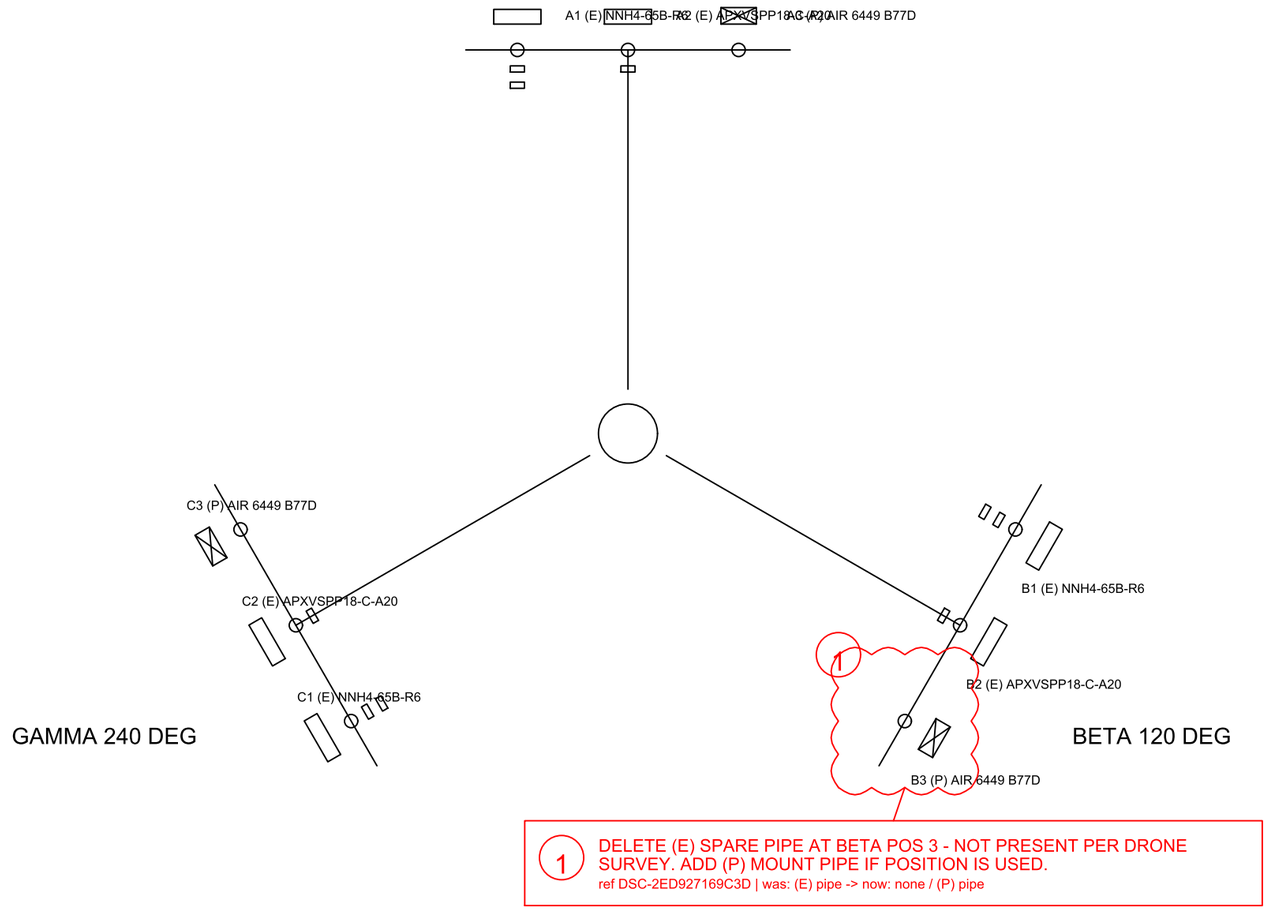

GAMMA 240 DEG

BETA 120 DEG

1 DELETE (E) SPARE PIPE AT BETA POS 3 - NOT PRESENT PER DRONE SURVEY. ADD (P) MOUNT PIPE IF POSITION IS USED.
ref DSC-2ED927169C3D | was: (E) pipe -> now: none / (P) pipe

(E) EXISTING (P) PROPOSED (R) REMOVE. EQUIPMENT DATA HELD IN BLOCK ATTRIBUTES.

MERIDIAN A&E GROUP

(SYNTHETIC SAMPLE)

CLIENT: ERICSSON

CARRIER: CARRIER-A

SITE ID: TXDA1024

SITE: LAKEWOOD HEIGHTS

6120 ABRAMS RD (SYNTHETIC)

DALLAS, TX 75214

STRUCTURE: MONOPOLE

HEIGHT: 150 FT

REV 1 2026-08-20

ISSUED FOR CONSTRUCTION

NOT FOR CONSTRUCTION -

SYNTHETIC POC DATA

SHEET TITLE:

ANTENNA LAYOUT PLAN

SHEET A-3

ANTENNA & EQUIPMENT SCHEDULE

SECTOR	AZ	POS	STATUS	TYPE	MANUFACTURER	MODEL	RC (FT)	M-TILT	BANDS
ALPHA	0	1	EXISTING	ANTENNA	COMMSCOPE	NNH4-65B-R6	145	0	LB/MB
ALPHA	0	1	EXISTING	RRU	ERICSSON	RADIO 4449 B5 B12	145	-	B5/B12
ALPHA	0	1	EXISTING	RRU	ERICSSON	RADIO 4460 B2 B66	145	-	B2/B66
ALPHA	0	2	EXISTING	ANTENNA	RFS	APXVSPP18-C-A20	145	0	MB
ALPHA	0	2	EXISTING	RRU	ERICSSON	RADIO 2217 B66A	145	-	B66
ALPHA	0	3	PROPOSED	AAU	ERICSSON	AIR 6449 B77D	138	1	n77
BETA	120	1	EXISTING	ANTENNA	COMMSCOPE	NNH4-65B-R6	145	0	LB/MB
BETA	120	1	EXISTING	RRU	ERICSSON	RADIO 4449 B5 B12	145	-	B5/B12
BETA	120	1	EXISTING	RRU	ERICSSON	RADIO 4460 B2 B66	145	-	B2/B66
BETA	120	2	EXISTING	ANTENNA	RFS	APXVSPP18-C-A20	145	2	MB
BETA	120	2	EXISTING	RRU	ERICSSON	RADIO 2217 B66A	145	-	B66
BETA	120	3	PROPOSED	AAU	ERICSSON	AIR 6449 B77D	138	0	n77
GAMMA	240	1	EXISTING	ANTENNA	COMMSCOPE	NNH4-65B-R6	145	1	LB/MB
GAMMA	240	1	EXISTING	RRU	ERICSSON	RADIO 4449 B5 B12	145	-	B5/B12
GAMMA	240	1	EXISTING	RRU	ERICSSON	RADIO 4460 B2 B66	145	-	B2/B66
GAMMA	240	2	EXISTING	ANTENNA	RFS	APXVSPP18-C-A20	145	1	MB
GAMMA	240	2	EXISTING	RRU	ERICSSON	RADIO 2217 B66A	145	-	B66
GAMMA	240	3	PROPOSED	AAU	ERICSSON	AIR 6449 B77D	138	0	n77

CABLE SCHEDULE (REQ'D = 1.10 x (VERT + HORIZ))

TRUNK	TYPE	FROM	TO	VERT (FT)	HORIZ (FT)	REQ'D (FT)	SPECIFIED
T1	HYBRID 6x12	BASE OVP / CABINET	TOP OVP	143	28	188.1	200 FT

JUMPER SCHEDULE

JUMPER	ROUTE	LENGTH	QTY
DC JUMPER 8 AWG	TOP OVP TO RRU	15 FT	0
FIBER JUMPER LC-LC	TOP OVP TO RRU	15 FT	0
DC JUMPER 8 AWG	TOP OVP TO AAU	20 FT	3
FIBER JUMPER LC-LC	TOP OVP TO AAU	20 FT	3

MERIDIAN A&E GROUP

(SYNTHETIC SAMPLE)

CLIENT: ERICSSON

CARRIER: CARRIER-A

SITE ID: TXDA1024

SITE: LAKEWOOD HEIGHTS

6120 ABRAMS RD (SYNTHETIC)

DALLAS, TX 75214

STRUCTURE: MONOPOLE

HEIGHT: 150 FT

REV 1 2026-08-20

ISSUED FOR CONSTRUCTION

NOT FOR CONSTRUCTION -

SYNTHETIC POC DATA


SHEET TITLE:

ANTENNA & CABLE SCHEDULE

SHEET A-4

GROUNDING PLAN

1. BOND EACH NEW RRU, AAU AND ANTENNA TO SECTOR GROUND BAR WITH #6 AWG.
2. GROUND HYBRID TRUNK AT TOP, BOTTOM AND MID-SPAN IF > 200 FT.
3. BOND TOP AND BASE OVP ENCLOSURES WITH #6 AWG.
4. ALL LUGS TWO-HOLE, TINNED, WITH ANTI-OXIDANT.

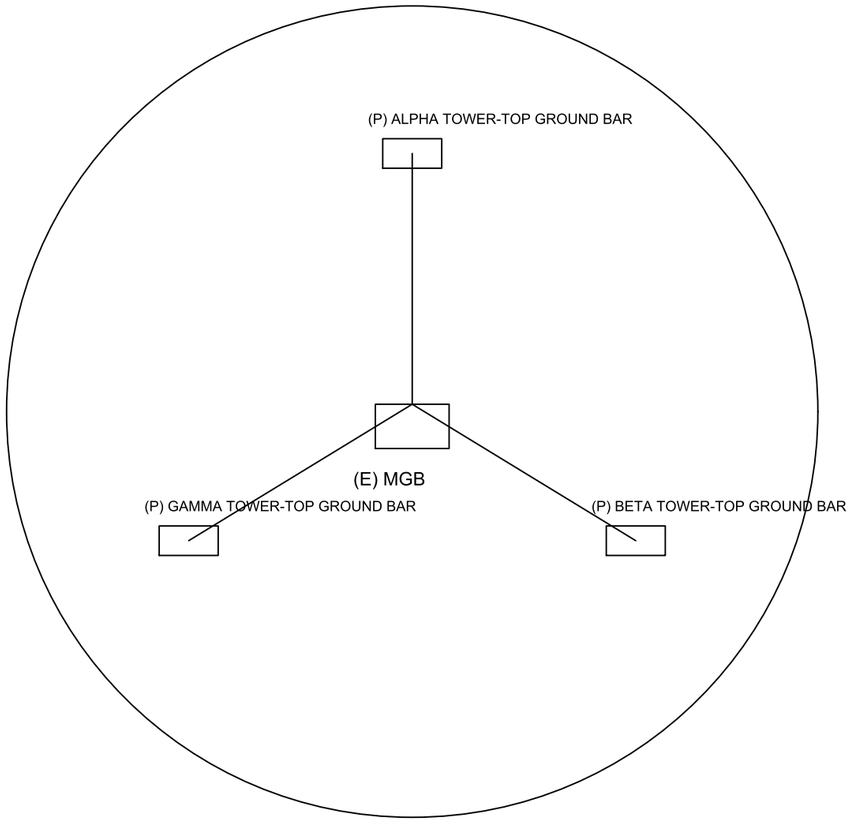

(E) GROUND RING #2 AWG BARE TINNED

MERIDIAN A&E GROUP

(SYNTHETIC SAMPLE)

CLIENT: ERICSSON

CARRIER: CARRIER-A

SITE ID: TXDA1024

SITE: LAKEWOOD HEIGHTS

6120 ABRAMS RD (SYNTHETIC)

DALLAS, TX 75214

STRUCTURE: MONOPOLE

HEIGHT: 150 FT

REV 1 2026-08-20

ISSUED FOR CONSTRUCTION

NOT FOR CONSTRUCTION -

SYNTHETIC POC DATA

SHEET TITLE:

GROUNDING PLAN & NOTES

SHEET E-1