REDLINE SUMMARY - TXCA0977 CD REV 1

ScopeIQ - 2026-10-28 - 2 markup(s) on TXCA0977_CD_REV1.dxf - status per ScopeIQ workflow

#	SHEET	MARKUP	FROM	TO	STATUS
1	A-3	ADD MOUNT REINFORCEMENT PER MA-TXCA0977-R0: ALPHA MRK x1. ADD TO T-1 SCOPE OF WORK.	not shown	ALPHA MRK x1	DRAFT
2	A-4	REVISE CABLE SCHEDULE HORIZ RUN 45 FT -> 18 FT (MEASURED). RECOMPUTE REQ'D LENGTH AND SPECIFIED TRUNK.	45 ft	18 ft	DRAFT

CARRIER-A - 5G C-BAND ADD

TXCA0977 CARROLLTON STATION

SCOPE OF WORK

1. INSTALL (3) AIR 6449 B77D
2. INSTALL (1) BASEBAND 6648 IN EXISTING CABINET
3. INSTALL (1) HYBRID TRUNK 6x12, 200 FT, WITH TOP AND BASE OVP
4. FIELD VERIFY ALL EXISTING CONDITIONS PRIOR TO CONSTRUCTION

SHEET INDEX

T-1 TITLE SHEET & SCOPE OF WORK
A-2 ELEVATION
A-3 ANTENNA LAYOUT PLAN
A-4 ANTENNA & CABLE SCHEDULE
E-1 GROUNDING PLAN & NOTES

SITE INFORMATION

SITE ID: TXCA0977
SITE NAME: Carrollton Station
MARKET: DFW
CUSTOMER: CARRIER-A
ADDRESS: 1900 E Belt Line Rd (synthetic)
CITY: Carrollton
STATE: TX
ZIP: 75006
LATITUDE: 32.9537
LONGITUDE: -96.8903
STRUCTURE TYPE: Monopole
STRUCTURE HEIGHT (FT): 110
STRUCTURE OWNER: BluePeak Towers
PROJECT TYPE: 5G C-band add

GENERAL NOTES

CONTRACTOR SHALL VERIFY ALL DIMENSIONS AND EXISTING CONDITIONS BEFORE ORDERING MATERIAL.
ALL WORK PER CARRIER BUILD STANDARDS AND TIA-222-H.
RF CONFIGURATION PER RFDS R3.
MOUNT AND STRUCTURAL ADEQUACY PER MA/SA REPORTS.

MERIDIAN A&E GROUP
(SYNTHETIC SAMPLE)

CLIENT: ERICSSON
CARRIER: CARRIER-A

SITE ID: TXCA0977
SITE: CARROLLTON STATION
1900 E BELT LINE RD (SYNTH
CARROLLTON, TX 75006


STRUCTURE: MONOPOLE
HEIGHT: 110 FT

REV 1 2026-08-31
ISSUED FOR CONSTRUCTION

NOT FOR CONSTRUCTION -
SYNTHETIC POC DATA

SHEET TITLE:
TITLE SHEET & SCOPE OF WORK

SHEET T-1

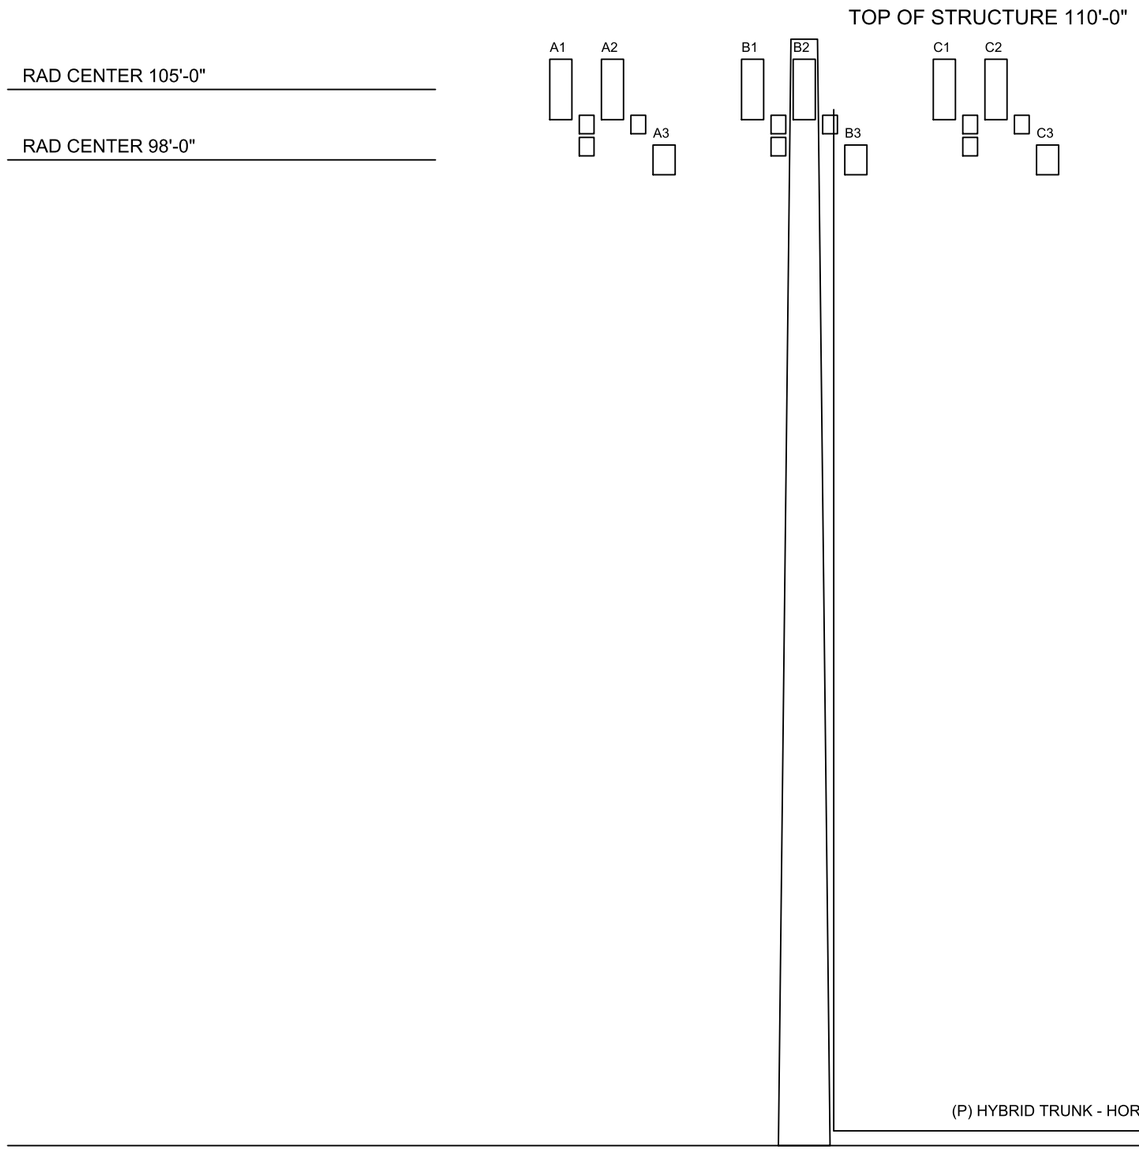

EQUIPMENT KEY

A1 (E) NNH4-65B-R6 RC 105'

A2 (E) APXVSPP18-C-A20 RC 105'

A3 (P) AIR 6449 B77D RC 98'

B1 (E) NNH4-65B-R6 RC 105'

B2 (E) APXVSPP18-C-A20 RC 105'

B3 (P) AIR 6449 B77D RC 98'

C1 (E) NNH4-65B-R6 RC 105'

C2 (E) APXVSPP18-C-A20 RC 105'

C3 (P) AIR 6449 B77D RC 98'

MERIDIAN A&E GROUP

(SYNTHETIC SAMPLE)

CLIENT: ERICSSON

CARRIER: CARRIER-A

SITE ID: TXCA0977

SITE: CARROLLTON STATION

1900 E BELT LINE RD (SYNTH

CARROLLTON, TX 75006

STRUCTURE: MONOPOLE

HEIGHT: 110 FT

REV 1 2026-08-31

ISSUED FOR CONSTRUCTION

NOT FOR CONSTRUCTION -


SYNTHETIC POC DATA

SHEET TITLE:

ELEVATION

SHEET A-2

N

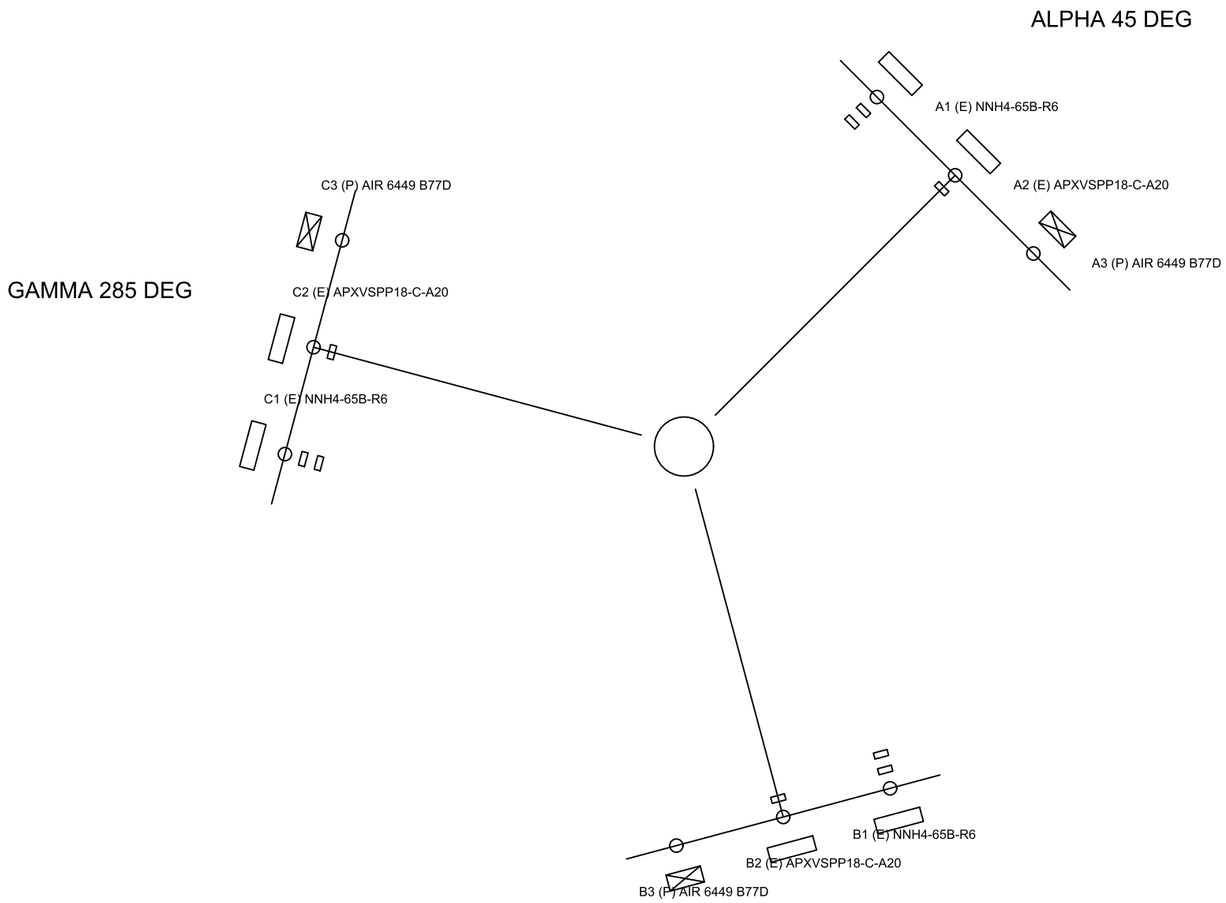

1 ADD MOUNT REINFORCEMENT PER MA-TXCA0977-R0: ALPHA MRK x1. ADD TO T-1 SCOPE OF WORK.
ref DSC-B0892B7F9B39 | was: not shown -> now: ALPHA MRK x1

(E) EXISTING (P) PROPOSED (R) REMOVE. EQUIPMENT DATA HELD IN BLOCK ATTRIBUTES.

MERIDIAN A&E GROUP

(SYNTHETIC SAMPLE)

CLIENT: ERICSSON

CARRIER: CARRIER-A

SITE ID: TXCA0977

SITE: CARROLLTON STATION

1900 E BELT LINE RD (SYNTH

CARROLLTON, TX 75006

STRUCTURE: MONOPOLE

HEIGHT: 110 FT

REV 1 2026-08-31

ISSUED FOR CONSTRUCTION

NOT FOR CONSTRUCTION -

SYNTHETIC POC DATA

SHEET TITLE:

ANTENNA LAYOUT PLAN

SHEET A-3

ANTENNA & EQUIPMENT SCHEDULE

SECTOR	AZ	POS	STATUS	TYPE	MANUFACTURER	MODEL	RC (FT)	M-TILT	BANDS
ALPHA	45	1	EXISTING	ANTENNA	COMMSCOPE	NNH4-65B-R6	105	0	LB/MB
ALPHA	45	1	EXISTING	RRU	ERICSSON	RADIO 4449 B5 B12	105	-	B5/B12
ALPHA	45	1	EXISTING	RRU	ERICSSON	RADIO 4460 B2 B66	105	-	B2/B66
ALPHA	45	2	EXISTING	ANTENNA	RFS	APXVSPP18-C-A20	105	2	MB
ALPHA	45	2	EXISTING	RRU	ERICSSON	RADIO 2217 B66A	105	-	B66
ALPHA	45	3	PROPOSED	AAU	ERICSSON	AIR 6449 B77D	98	1	n77
BETA	165	1	EXISTING	ANTENNA	COMMSCOPE	NNH4-65B-R6	105	0	LB/MB
BETA	165	1	EXISTING	RRU	ERICSSON	RADIO 4449 B5 B12	105	-	B5/B12
BETA	165	1	EXISTING	RRU	ERICSSON	RADIO 4460 B2 B66	105	-	B2/B66
BETA	165	2	EXISTING	ANTENNA	RFS	APXVSPP18-C-A20	105	2	MB
BETA	165	2	EXISTING	RRU	ERICSSON	RADIO 2217 B66A	105	-	B66
BETA	165	3	PROPOSED	AAU	ERICSSON	AIR 6449 B77D	98	0	n77
GAMMA	285	1	EXISTING	ANTENNA	COMMSCOPE	NNH4-65B-R6	105	2	LB/MB
GAMMA	285	1	EXISTING	RRU	ERICSSON	RADIO 4449 B5 B12	105	-	B5/B12
GAMMA	285	1	EXISTING	RRU	ERICSSON	RADIO 4460 B2 B66	105	-	B2/B66
GAMMA	285	2	EXISTING	ANTENNA	RFS	APXVSPP18-C-A20	105	1	MB
GAMMA	285	2	EXISTING	RRU	ERICSSON	RADIO 2217 B66A	105	-	B66
GAMMA	285	3	PROPOSED	AAU	ERICSSON	AIR 6449 B77D	98	2	n77

CABLE SCHEDULE (REQ'D = 1.10 x (VERT + HORIZ))

TRUNK	TYPE	FROM	TO	VERT (FT)	HORIZ (FT)	REQ'D (FT)	SPECIFIED
T1	HYBRID 6x12	BASE OVP / CABINET	TOP OVP	103	45	162.8	200 FT

JUMPER SCHEDULE

JUMPER	ROUTE	LENGTH	QTY
DC JUMPER 8 AWG	TOP OVP TO RRU	15 FT	0
FIBER JUMPER LC-LC	TOP OVP TO RRU	15 FT	0
DC JUMPER 8 AWG	TOP OVP TO AAU	20 FT	3
FIBER JUMPER LC-LC	TOP OVP TO AAU	20 FT	3

2

2 REVISE CABLE SCHEDULE HORIZ RUN 45 FT -> 18 FT (MEASURED). RECOMPUTE REQ'D LENGTH AND SPECIFIED TRUNK.
ref DSC-BCDF44AF6EA7 | was: 45 ft -> now: 18 ft

MERIDIAN A&E GROUP

(SYNTHETIC SAMPLE)

CLIENT: ERICSSON

CARRIER: CARRIER-A

SITE ID: TXCA0977

SITE: CARROLLTON STATION

1900 E BELT LINE RD (SYNTH

CARROLLTON, TX 75006

STRUCTURE: MONOPOLE

HEIGHT: 110 FT

REV 1 2026-08-31

ISSUED FOR CONSTRUCTION

NOT FOR CONSTRUCTION -

SYNTHETIC POC DATA


SHEET TITLE:

ANTENNA & CABLE SCHEDULE

SHEET A-4

GROUNDING PLAN

1. BOND EACH NEW RRU, AAU AND ANTENNA TO SECTOR GROUND BAR WITH #6 AWG.
2. GROUND HYBRID TRUNK AT TOP, BOTTOM AND MID-SPAN IF > 200 FT.
3. BOND TOP AND BASE OVP ENCLOSURES WITH #6 AWG.
4. ALL LUGS TWO-HOLE, TINNED, WITH ANTI-OXIDANT.

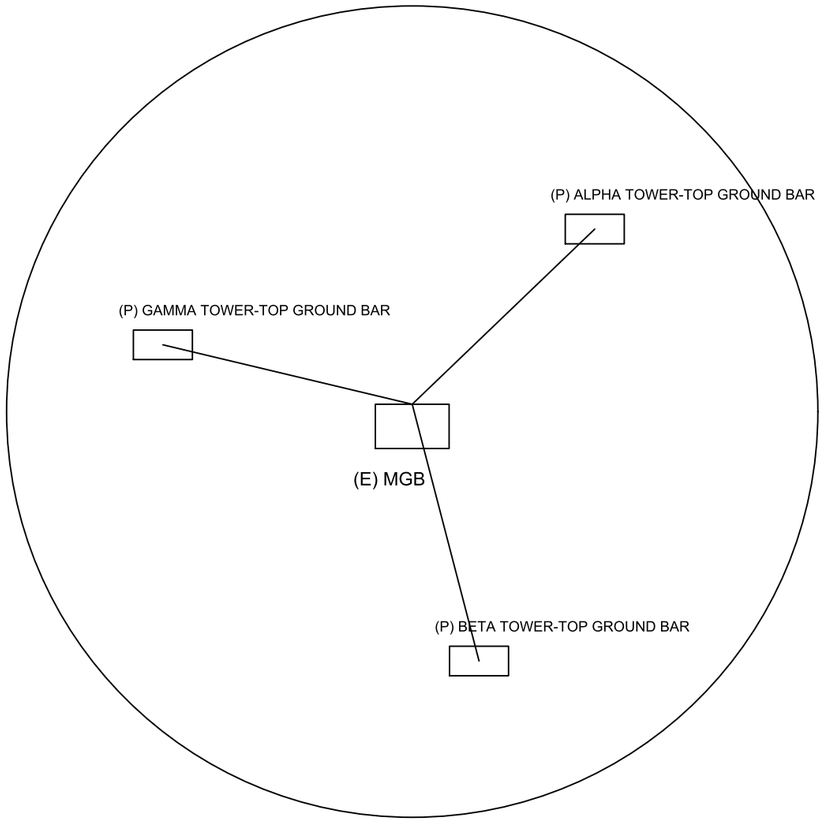

(E) GROUND RING #2 AWG BARE TINNED

MERIDIAN A&E GROUP

(SYNTHETIC SAMPLE)

CLIENT: ERICSSON

CARRIER: CARRIER-A

SITE ID: TXCA0977

SITE: CARROLLTON STATION

1900 E BELT LINE RD (SYNTH

CARROLLTON, TX 75006

STRUCTURE: MONOPOLE

HEIGHT: 110 FT

REV 1 2026-08-31

ISSUED FOR CONSTRUCTION

NOT FOR CONSTRUCTION -

SYNTHETIC POC DATA

SHEET TITLE:

GROUNDING PLAN & NOTES

SHEET E-1