REDLINE SUMMARY - TXPL0588 CD REV 1

ScopeIQ - 2026-10-28 - 2 markup(s) on TXPL0588_CD_REV1.dxf - status per ScopeIQ workflow

#	SHEET	MARKUP	FROM	TO	STATUS
1	A-3	ADD MOUNT REINFORCEMENT PER MA-TXPL0588-R0: ALPHA MRK x1, BETA MRK x1, GAMMA MRK x1. ADD TO T-1 SCOPE OF WORK.	not shown	ALPHA MRK x1, BETA MRK	DRAFT
2	A-3	ADD UNRECORDED (E) RRUS 11 B12 AT GAMMA POS 1 TO EXISTING INVENTORY AND MARK (R) REMOVE.	not shown	(E)/(R) RRUS11	DRAFT

CARRIER-A - N41 ADD + LOW-BAND REFRESH

TXPL0588 LEGACY DRIVE

SCOPE OF WORK

1. INSTALL (3) NNH4-65B-R6
2. INSTALL (3) RADIO 4480 B71 B85
3. INSTALL (3) AIR 6419 B41
4. REMOVE (3) APXVSPP18-C-A20
5. REMOVE (3) RADIO 2217 B66A
6. INSTALL (1) BASEBAND 6651 IN EXISTING CABINET
7. INSTALL (1) HYBRID TRUNK 6x12, 200 FT, WITH TOP AND BASE OVP
8. FIELD VERIFY ALL EXISTING CONDITIONS PRIOR TO CONSTRUCTION

SHEET INDEX

T-1 TITLE SHEET & SCOPE OF WORK
A-2 ELEVATION
A-3 ANTENNA LAYOUT PLAN
A-4 ANTENNA & CABLE SCHEDULE
E-1 GROUNDING PLAN & NOTES

SITE INFORMATION

SITE ID: TXPL0588
SITE NAME: Legacy Drive
MARKET: DFW
CUSTOMER: CARRIER-A
ADDRESS: 5800 Tennyson Pkwy (synthetic)
CITY: Plano
STATE: TX
ZIP: 75024
LATITUDE: 33.0768
LONGITUDE: -96.821
STRUCTURE TYPE: Monopole
STRUCTURE HEIGHT (FT): 125
STRUCTURE OWNER: Lonestar Tower Partners
PROJECT TYPE: n41 add + low-band refresh

GENERAL NOTES

CONTRACTOR SHALL VERIFY ALL DIMENSIONS AND EXISTING CONDITIONS BEFORE ORDERING MATERIAL.
ALL WORK PER CARRIER BUILD STANDARDS AND TIA-222-H.
RF CONFIGURATION PER RFDS R3.
MOUNT AND STRUCTURAL ADEQUACY PER MA/SA REPORTS.

MERIDIAN A&E GROUP
(SYNTHETIC SAMPLE)

CLIENT: ERICSSON
CARRIER: CARRIER-A

SITE ID: TXPL0588
SITE: LEGACY DRIVE
5800 TENNYSON PKWY (SYNTHE
PLANO, TX 75024


STRUCTURE: MONOPOLE
HEIGHT: 125 FT

REV 1 2026-08-22
ISSUED FOR CONSTRUCTION

NOT FOR CONSTRUCTION -
SYNTHETIC POC DATA

SHEET TITLE:
TITLE SHEET & SCOPE OF WORK

SHEET T-1

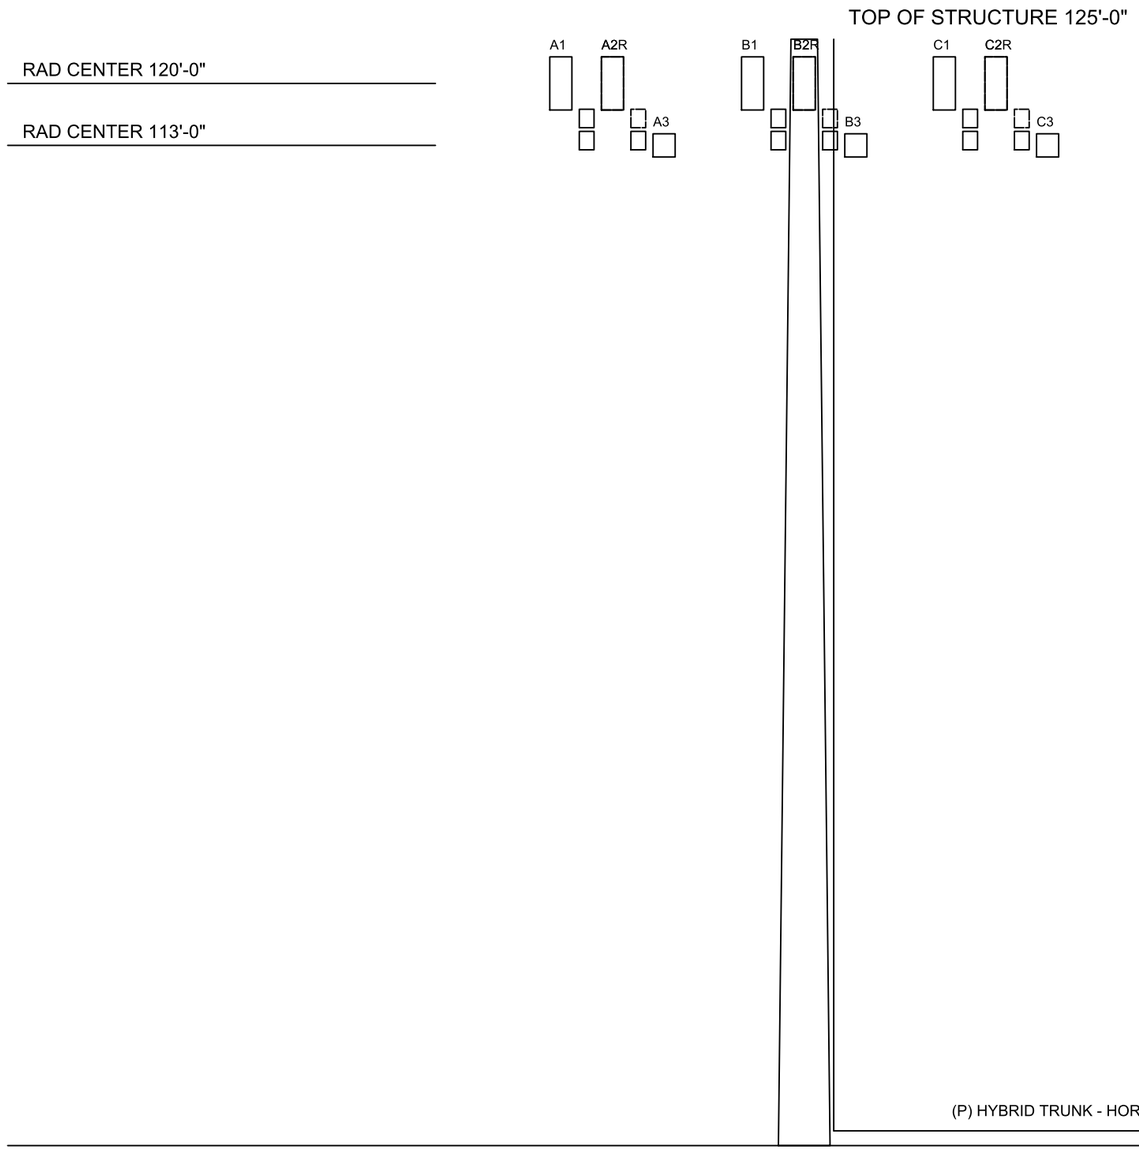

EQUIPMENT KEY

A1 (E) NNH4-65B-R6 RC 120'

A2R (R) APXVSPP18-C-A20 RC 120'

A2 (P) NNH4-65B-R6 RC 120'

A3 (P) AIR 6419 B41 RC 113'

B1 (E) NNH4-65B-R6 RC 120'

B2R (R) APXVSPP18-C-A20 RC 120'

B2 (P) NNH4-65B-R6 RC 120'

B3 (P) AIR 6419 B41 RC 113'

C1 (E) NNH4-65B-R6 RC 120'

C2R (R) APXVSPP18-C-A20 RC 120'

C2 (P) NNH4-65B-R6 RC 120'

C3 (P) AIR 6419 B41 RC 113'

MERIDIAN A&E GROUP

(SYNTHETIC SAMPLE)

CLIENT: ERICSSON

CARRIER: CARRIER-A

SITE ID: TXPL0588

SITE: LEGACY DRIVE

5800 TENNYSON PKWY (SYNTHE

PLANO, TX 75024

STRUCTURE: MONOPOLE

HEIGHT: 125 FT

REV 1 2026-08-22

ISSUED FOR CONSTRUCTION

NOT FOR CONSTRUCTION -

SYNTHETIC POC DATA


SHEET TITLE:

ELEVATION

SHEET A-2

N

ALPHA 10 DEG

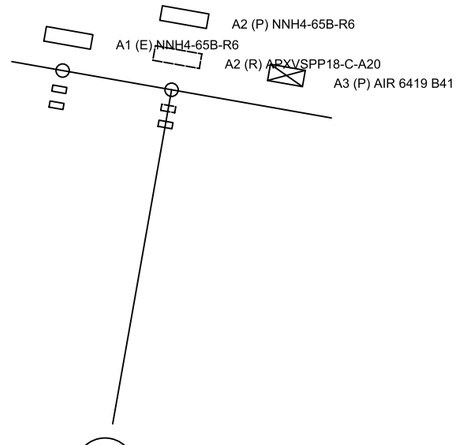

2 ADD UNRECORDED (E) RRUS 11 B12 AT GAMMA POS 1 TO EXISTING INVENTORY AND MARK (R) REMOVE.
ref DSC-72E4285C94EB | was: not shown -> now: (E)/(R) RRUS11

1 ADD MOUNT REINFORCEMENT PER MA-TXPL0588-R0: ALPHA MRK x1, BETA MRK x1, GAMMA MRK x1. ADD TO T-1 SCOPE OF WORK.
ref DSC-0C6EF257FBA2 | was: not shown -> now: ALPHA MRK x1, BETA MRK x1, GAMMA M

(E) EXISTING (P) PROPOSED (R) REMOVE. EQUIPMENT DATA HELD IN BLOCK ATTRIBUTES.

MERIDIAN A&E GROUP

(SYNTHETIC SAMPLE)

CLIENT: ERICSSON

CARRIER: CARRIER-A

SITE ID: TXPL0588

SITE: LEGACY DRIVE

5800 TENNYSON PKWY (SYNTHE

PLANO, TX 75024

STRUCTURE: MONOPOLE

HEIGHT: 125 FT

REV 1 2026-08-22

ISSUED FOR CONSTRUCTION

NOT FOR CONSTRUCTION -

SYNTHETIC POC DATA

SHEET TITLE:

ANTENNA LAYOUT PLAN

SHEET A-3

ANTENNA & EQUIPMENT SCHEDULE

SECTOR	AZ	POS	STATUS	TYPE	MANUFACTURER	MODEL	RC (FT)	M-TILT	BANDS
ALPHA	10	1	EXISTING	ANTENNA	COMMSCOPE	NNH4-65B-R6	120	2	LB/MB
ALPHA	10	1	EXISTING	RRU	ERICSSON	RADIO 4449 B5 B12	120	-	B5/B12
ALPHA	10	1	EXISTING	RRU	ERICSSON	RADIO 4460 B2 B66	120	-	B2/B66
ALPHA	10	2	REMOVE	ANTENNA	RFS	APXVSPP18-C-A20	120	0	MB
ALPHA	10	2	PROPOSED	ANTENNA	COMMSCOPE	NNH4-65B-R6	120	0	LB/MB
ALPHA	10	2	REMOVE	RRU	ERICSSON	RADIO 2217 B66A	120	-	B66
ALPHA	10	2	PROPOSED	RRU	ERICSSON	RADIO 4480 B71 B85	120	-	B71/B85
ALPHA	10	3	PROPOSED	AAU	ERICSSON	AIR 6419 B41	113	0	n41
BETA	130	1	EXISTING	ANTENNA	COMMSCOPE	NNH4-65B-R6	120	0	LB/MB
BETA	130	1	EXISTING	RRU	ERICSSON	RADIO 4449 B5 B12	120	-	B5/B12
BETA	130	1	EXISTING	RRU	ERICSSON	RADIO 4460 B2 B66	120	-	B2/B66
BETA	130	2	REMOVE	ANTENNA	RFS	APXVSPP18-C-A20	120	0	MB
BETA	130	2	PROPOSED	ANTENNA	COMMSCOPE	NNH4-65B-R6	120	0	LB/MB
BETA	130	2	REMOVE	RRU	ERICSSON	RADIO 2217 B66A	120	-	B66
BETA	130	2	PROPOSED	RRU	ERICSSON	RADIO 4480 B71 B85	120	-	B71/B85
BETA	130	3	PROPOSED	AAU	ERICSSON	AIR 6419 B41	113	1	n41
GAMMA	250	1	EXISTING	ANTENNA	COMMSCOPE	NNH4-65B-R6	120	2	LB/MB
GAMMA	250	1	EXISTING	RRU	ERICSSON	RADIO 4449 B5 B12	120	-	B5/B12
GAMMA	250	1	EXISTING	RRU	ERICSSON	RADIO 4460 B2 B66	120	-	B2/B66
GAMMA	250	2	REMOVE	ANTENNA	RFS	APXVSPP18-C-A20	120	0	MB
GAMMA	250	2	PROPOSED	ANTENNA	COMMSCOPE	NNH4-65B-R6	120	0	LB/MB
GAMMA	250	2	REMOVE	RRU	ERICSSON	RADIO 2217 B66A	120	-	B66
GAMMA	250	2	PROPOSED	RRU	ERICSSON	RADIO 4480 B71 B85	120	-	B71/B85
GAMMA	250	3	PROPOSED	AAU	ERICSSON	AIR 6419 B41	113	1	n41

CABLE SCHEDULE (REQ'D = 1.10 x (VERT + HORIZ))

TRUNK	TYPE	FROM	TO	VERT (FT)	HORIZ (FT)	REQ'D (FT)	SPECIFIED
T1	HYBRID 6x12	BASE OVP / CABINET	TOP OVP	125	22	161.7	200 FT

JUMPER SCHEDULE

JUMPER	ROUTE	LENGTH	QTY
DC JUMPER 8 AWG	TOP OVP TO RRU	15 FT	3
FIBER JUMPER LC-LC	TOP OVP TO RRU	15 FT	3
DC JUMPER 8 AWG	TOP OVP TO AAU	20 FT	3
FIBER JUMPER LC-LC	TOP OVP TO AAU	20 FT	3

MERIDIAN A&E GROUP

(SYNTHETIC SAMPLE)

CLIENT: ERICSSON

CARRIER: CARRIER-A

SITE ID: TXPL0588

SITE: LEGACY DRIVE

5800 TENNYSON PKWY (SYNTHE

PLANO, TX 75024

STRUCTURE: MONOPOLE

HEIGHT: 125 FT

REV 1 2026-08-22

ISSUED FOR CONSTRUCTION

NOT FOR CONSTRUCTION -

SYNTHETIC POC DATA


SHEET TITLE:

ANTENNA & CABLE SCHEDULE

SHEET A-4

GROUNDING PLAN

1. BOND EACH NEW RRU, AAU AND ANTENNA TO SECTOR GROUND BAR WITH #6 AWG.
2. GROUND HYBRID TRUNK AT TOP, BOTTOM AND MID-SPAN IF > 200 FT.
3. BOND TOP AND BASE OVP ENCLOSURES WITH #6 AWG.
4. ALL LUGS TWO-HOLE, TINNED, WITH ANTI-OXIDANT.

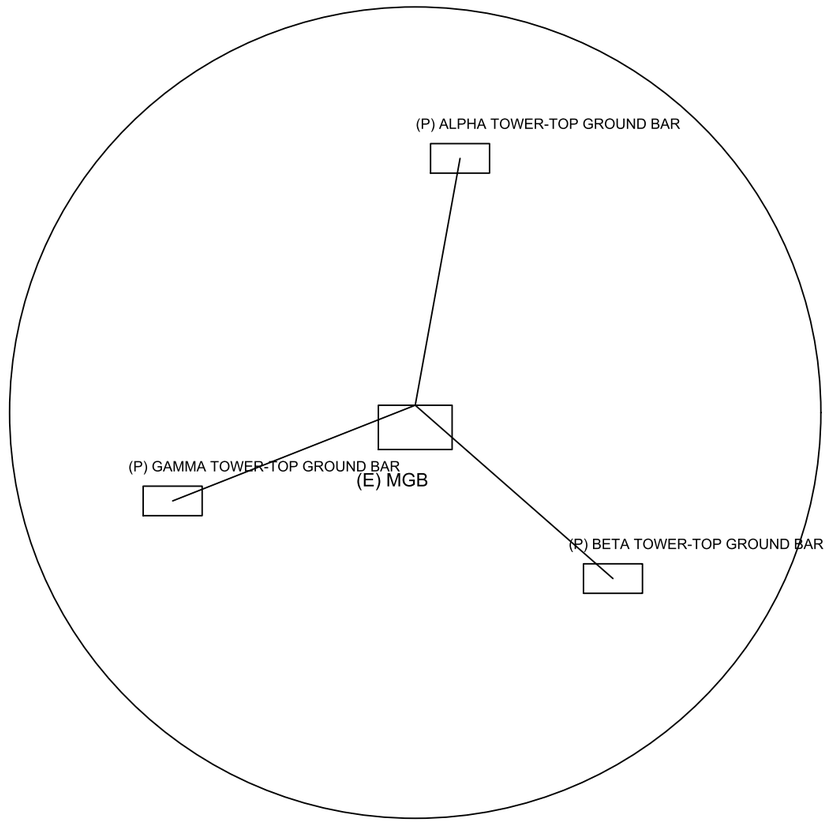

(E) GROUND RING #2 AWG BARE TINNED

MERIDIAN A&E GROUP

(SYNTHETIC SAMPLE)

CLIENT: ERICSSON

CARRIER: CARRIER-A

SITE ID: TXPL0588

SITE: LEGACY DRIVE

5800 TENNYSON PKWY (SYNTHE

PLANO, TX 75024

STRUCTURE: MONOPOLE

HEIGHT: 125 FT

REV 1 2026-08-22

ISSUED FOR CONSTRUCTION

NOT FOR CONSTRUCTION -

SYNTHETIC POC DATA

SHEET TITLE:

GROUNDING PLAN & NOTES

SHEET E-1