REDLINE SUMMARY - TXRI0906 CD REV 1

ScopeIQ - 2026-10-28 - 1 markup(s) on TXRI0906_CD_REV1.dxf - status per ScopeIQ workflow

#	SHEET	MARKUP	FROM	TO	STATUS
1	A-3	(E) ROOF SLED AT DELTA NOT PRESENT PER DRONE SURVEY - REVISE TO (P) NON-PENETRATING ROOF SLED.	(E) roof sled	(P) roof sled	DRAFT

CARRIER-A - 5G C-BAND ADD + NEW SECTOR

TXRI0906 COLLINS TOWER

SCOPE OF WORK

1. INSTALL (4) AIR 6449 B77D
2. INSTALL (1) BASEBAND 6648 IN EXISTING CABINET
3. INSTALL (1) HYBRID TRUNK 6x12, 100 FT, WITH TOP AND BASE OVP
4. FIELD VERIFY ALL EXISTING CONDITIONS PRIOR TO CONSTRUCTION

SHEET INDEX

T-1 TITLE SHEET & SCOPE OF WORK
A-2 ELEVATION
A-3 ANTENNA LAYOUT PLAN
A-4 ANTENNA & CABLE SCHEDULE
E-1 GROUNDING PLAN & NOTES

SITE INFORMATION

SITE ID: TXRI0906
SITE NAME: Collins Tower
MARKET: DFW
CUSTOMER: CARRIER-A
ADDRESS: 1300 E Collins Blvd (synthetic)
CITY: Richardson
STATE: TX
ZIP: 75080
LATITUDE: 32.9857
LONGITUDE: -96.7108
STRUCTURE TYPE: Rooftop
STRUCTURE HEIGHT (FT): 85
STRUCTURE OWNER: Collins Tower LLC (building owner)
PROJECT TYPE: 5G C-band add + new sector

GENERAL NOTES

CONTRACTOR SHALL VERIFY ALL DIMENSIONS AND EXISTING CONDITIONS BEFORE ORDERING MATERIAL.
ALL WORK PER CARRIER BUILD STANDARDS AND TIA-222-H.
RF CONFIGURATION PER RFDS R3.
MOUNT AND STRUCTURAL ADEQUACY PER MA/SA REPORTS.

MERIDIAN A&E GROUP
(SYNTHETIC SAMPLE)

CLIENT: ERICSSON
CARRIER: CARRIER-A

SITE ID: TXRI0906
SITE: COLLINS TOWER
1300 E COLLINS BLVD (SYNTH
RICHARDSON, TX 75080


STRUCTURE: ROOFTOP
HEIGHT: 85 FT

REV 1 2026-08-28
ISSUED FOR CONSTRUCTION

NOT FOR CONSTRUCTION -
SYNTHETIC POC DATA

SHEET TITLE:
TITLE SHEET & SCOPE OF WORK

SHEET T-1

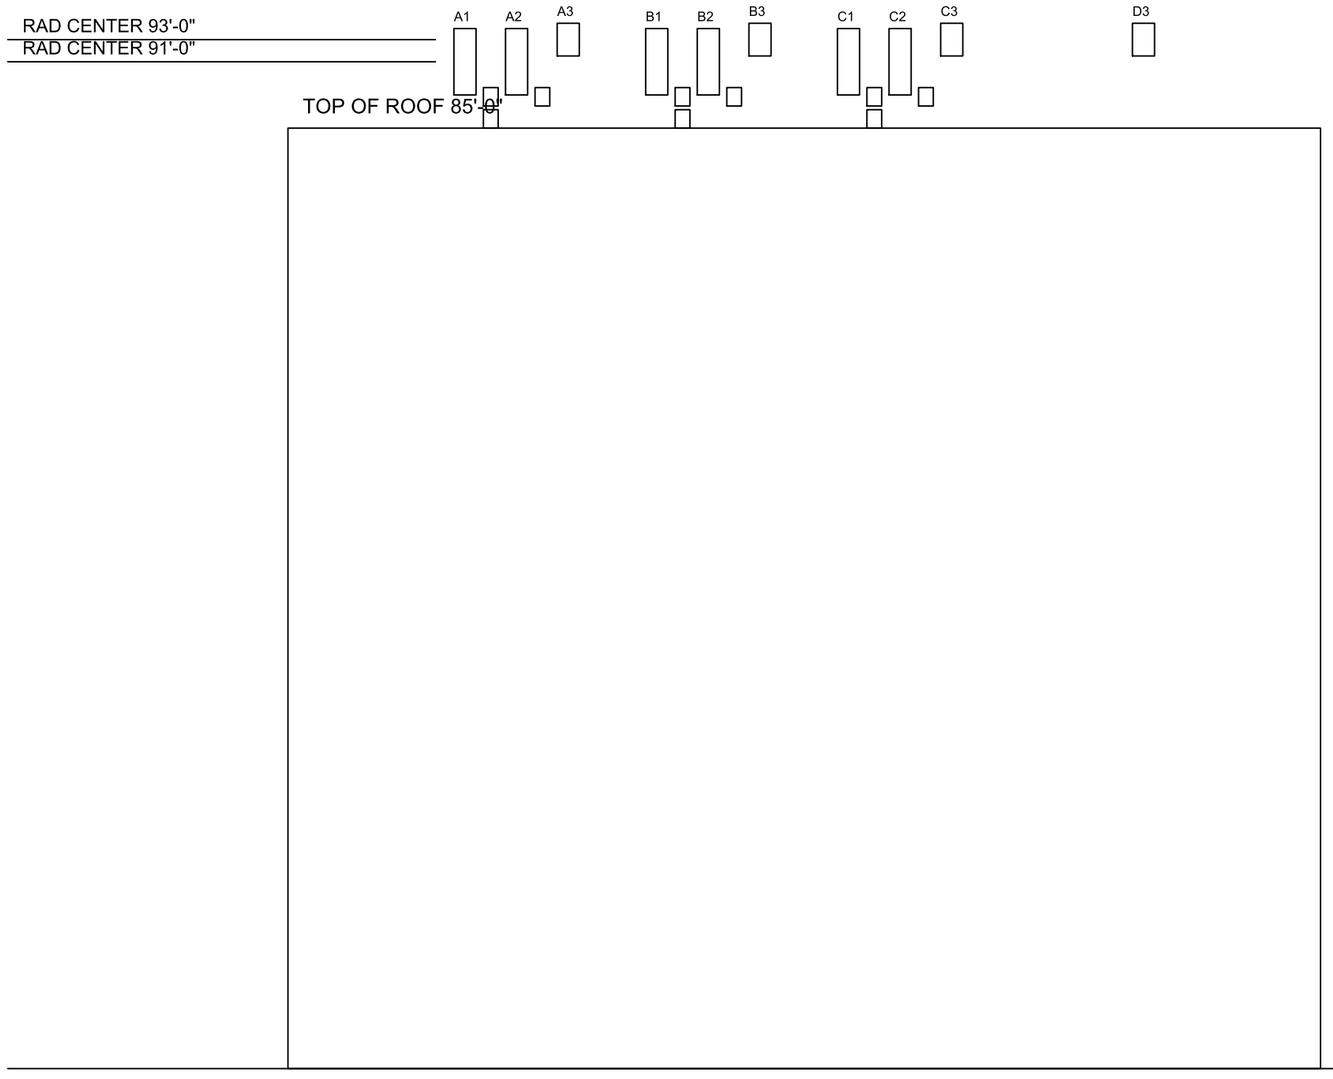

EQUIPMENT KEY

A1 (E) NNH4-65B-R6 RC 91'

A2 (E) APXVSPP18-C-A20 RC 91'

A3 (P) AIR 6449 B77D RC 93'

B1 (E) NNH4-65B-R6 RC 91'

B2 (E) APXVSPP18-C-A20 RC 91'

B3 (P) AIR 6449 B77D RC 93'

C1 (E) NNH4-65B-R6 RC 91'

C2 (E) APXVSPP18-C-A20 RC 91'

C3 (P) AIR 6449 B77D RC 93'

D3 (P) AIR 6449 B77D RC 93'

MERIDIAN A&E GROUP

(SYNTHETIC SAMPLE)

CLIENT: ERICSSON

CARRIER: CARRIER-A

SITE ID: TXRI0906

SITE: COLLINS TOWER

1300 E COLLINS BLVD (SYNTH

RICHARDSON, TX 75080

STRUCTURE: ROOFTOP

HEIGHT: 85 FT

REV 1 2026-08-28

ISSUED FOR CONSTRUCTION

NOT FOR CONSTRUCTION -

SYNTHETIC POC DATA

SHEET TITLE:

ELEVATION

SHEET A-2

N

ALPHA 30 DEG

1 (E) ROOF SLED AT DELTA NOT PRESENT PER DRONE SURVEY - REVISE TO (P) NON-PENETRATING ROOF SLED.
ref DSC-601253B8C7CF | was: (E) roof sled -> now: (P) roof sled

1

DELTA 300 DEG

D3 (P) AIR 6449 B77D

(E) ROOF SLED

A1 (E) NNH4-65B-R6

A2 (E) APXVSPP18-C-A20

A3 (P) AIR 6449 B77D

(E) ROOF SLED

(E) ROOF SLED

B1 (E) NNH4-65B-R6

B2 (E) APXVSPP18-C-A20

BETA 120 DEG

B3 (P) AIR 6449 B77D

C3 (P) AIR 6449 B77D

(E) ROOF SLED

C2 (E) APXVSPP18-C-A20

C1 (E) NNH4-65B-R6

ROOF OUTLINE (E)

GAMMA 210 DEG

(E) EXISTING (P) PROPOSED (R) REMOVE. EQUIPMENT DATA HELD IN BLOCK ATTRIBUTES.

MERIDIAN A&E GROUP

(SYNTHETIC SAMPLE)

CLIENT: ERICSSON

CARRIER: CARRIER-A

SITE ID: TXRI0906

SITE: COLLINS TOWER

1300 E COLLINS BLVD (SYNTH

RICHARDSON, TX 75080

STRUCTURE: ROOFTOP

HEIGHT: 85 FT

REV 1 2026-08-28

ISSUED FOR CONSTRUCTION

NOT FOR CONSTRUCTION -

SYNTHETIC POC DATA

SHEET TITLE:

ANTENNA LAYOUT PLAN

SHEET A-3

ANTENNA & EQUIPMENT SCHEDULE

SECTOR	AZ	POS	STATUS	TYPE	MANUFACTURER	MODEL	RC (FT)	M-TILT	BANDS
ALPHA	30	1	EXISTING	ANTENNA	COMMSCOPE	NNH4-65B-R6	91	1	LB/MB
ALPHA	30	1	EXISTING	RRU	ERICSSON	RADIO 4449 B5 B12	91	-	B5/B12
ALPHA	30	1	EXISTING	RRU	ERICSSON	RADIO 4460 B2 B66	91	-	B2/B66
ALPHA	30	2	EXISTING	ANTENNA	RFS	APXVSPP18-C-A20	91	1	MB
ALPHA	30	2	EXISTING	RRU	ERICSSON	RADIO 2217 B66A	91	-	B66
ALPHA	30	3	PROPOSED	AAU	ERICSSON	AIR 6449 B77D	93	2	n77
BETA	120	1	EXISTING	ANTENNA	COMMSCOPE	NNH4-65B-R6	91	2	LB/MB
BETA	120	1	EXISTING	RRU	ERICSSON	RADIO 4449 B5 B12	91	-	B5/B12
BETA	120	1	EXISTING	RRU	ERICSSON	RADIO 4460 B2 B66	91	-	B2/B66
BETA	120	2	EXISTING	ANTENNA	RFS	APXVSPP18-C-A20	91	2	MB
BETA	120	2	EXISTING	RRU	ERICSSON	RADIO 2217 B66A	91	-	B66
BETA	120	3	PROPOSED	AAU	ERICSSON	AIR 6449 B77D	93	0	n77
GAMMA	210	1	EXISTING	ANTENNA	COMMSCOPE	NNH4-65B-R6	91	2	LB/MB
GAMMA	210	1	EXISTING	RRU	ERICSSON	RADIO 4449 B5 B12	91	-	B5/B12
GAMMA	210	1	EXISTING	RRU	ERICSSON	RADIO 4460 B2 B66	91	-	B2/B66
GAMMA	210	2	EXISTING	ANTENNA	RFS	APXVSPP18-C-A20	91	2	MB
GAMMA	210	2	EXISTING	RRU	ERICSSON	RADIO 2217 B66A	91	-	B66
GAMMA	210	3	PROPOSED	AAU	ERICSSON	AIR 6449 B77D	93	1	n77
DELTA	300	3	PROPOSED	AAU	ERICSSON	AIR 6449 B77D	93	1	n77

CABLE SCHEDULE (REQ'D = 1.10 x (VERT + HORIZ))

TRUNK	TYPE	FROM	TO	VERT (FT)	HORIZ (FT)	REQ'D (FT)	SPECIFIED
T1	HYBRID 6x12	BASE OVP / CABINET	TOP OVP	10	60	77.0	100 FT

JUMPER SCHEDULE

JUMPER	ROUTE	LENGTH	QTY
DC JUMPER 8 AWG	TOP OVP TO RRU	15 FT	0
FIBER JUMPER LC-LC	TOP OVP TO RRU	15 FT	0
DC JUMPER 8 AWG	TOP OVP TO AAU	20 FT	4
FIBER JUMPER LC-LC	TOP OVP TO AAU	20 FT	4

MERIDIAN A&E GROUP

(SYNTHETIC SAMPLE)

CLIENT: ERICSSON

CARRIER: CARRIER-A

SITE ID: TXRI0906

SITE: COLLINS TOWER

1300 E COLLINS BLVD (SYNTH

RICHARDSON, TX 75080

STRUCTURE: ROOFTOP

HEIGHT: 85 FT

REV 1 2026-08-28

ISSUED FOR CONSTRUCTION

NOT FOR CONSTRUCTION -


SYNTHETIC POC DATA

SHEET TITLE:

ANTENNA & CABLE SCHEDULE

SHEET A-4

GROUNDING PLAN

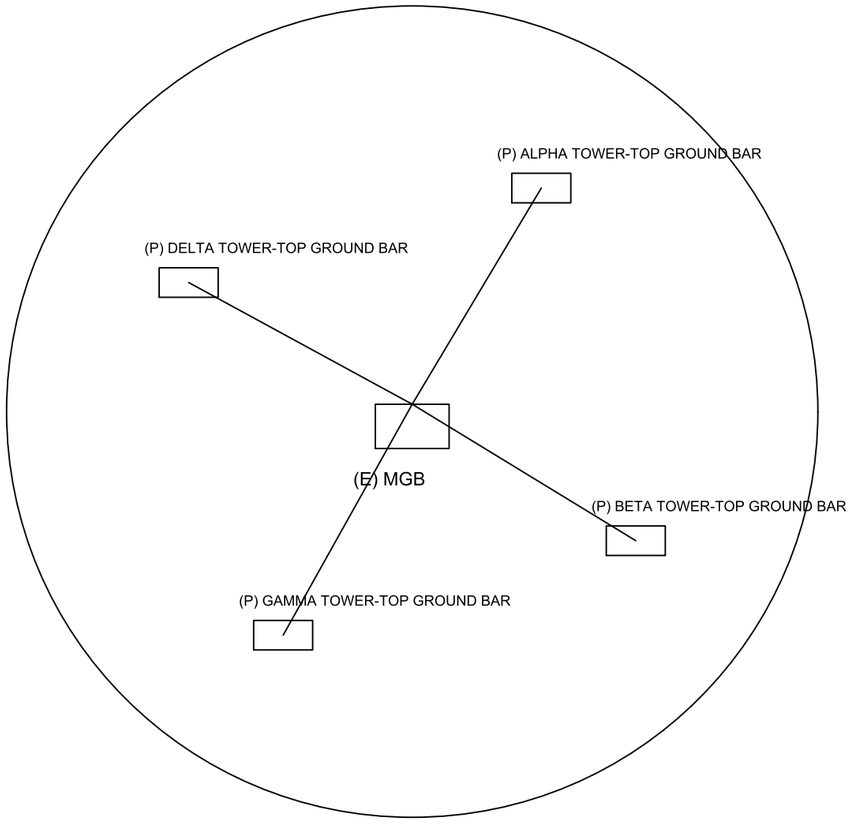

(E) GROUND RING #2 AWG BARE TINNED

1. BOND EACH NEW RRU, AAU AND ANTENNA TO SECTOR GROUND BAR WITH #6 AWG.
2. GROUND HYBRID TRUNK AT TOP, BOTTOM AND MID-SPAN IF > 200 FT.
3. BOND TOP AND BASE OVP ENCLOSURES WITH #6 AWG.
4. ALL LUGS TWO-HOLE, TINNED, WITH ANTI-OXIDANT.

MERIDIAN A&E GROUP

(SYNTHETIC SAMPLE)

CLIENT: ERICSSON

CARRIER: CARRIER-A

SITE ID: TXRI0906

SITE: COLLINS TOWER

1300 E COLLINS BLVD (SYNTH

RICHARDSON, TX 75080

STRUCTURE: ROOFTOP

HEIGHT: 85 FT

REV 1 2026-08-28

ISSUED FOR CONSTRUCTION

NOT FOR CONSTRUCTION -

SYNTHETIC POC DATA

SHEET TITLE:

GROUNDING PLAN & NOTES

SHEET E-1