REDLINE SUMMARY - TXAD0405 CD

ScopeIQ - 2026-10-26 - 1 markup(s) - status per ScopeIQ workflow

#	SHEET	MARKUP	FROM	TO	STATUS
1	A-2	REVISE RAD CENTER OF EXISTING ANTENNAS 63 FT -> 67.9 FT (MEASURED).	63 ft	67.9 ft	DRAFT

CARRIER-A - N41 ADD + LOW-BAND REFRESH

TXAD0405 UPTOWN PLAZA

SCOPE OF WORK

1. INSTALL (2) NNH4-65B-R6
2. INSTALL (2) RADIO 4480 B71 B85
3. INSTALL (2) AIR 6419 B41
4. REMOVE (2) APXVSPP18-C-A20
5. REMOVE (2) RADIO 2217 B66A
6. INSTALL (1) BASEBAND 6651 IN EXISTING CABINET
7. INSTALL (1) HYBRID TRUNK 6x12, 100 FT, WITH TOP AND BASE OVP
8. FIELD VERIFY ALL EXISTING CONDITIONS PRIOR TO CONSTRUCTION

SHEET INDEX

T-1 TITLE SHEET & SCOPE OF WORK
A-2 ELEVATION
A-3 ANTENNA LAYOUT PLAN
A-4 ANTENNA & CABLE SCHEDULE
E-1 GROUNDING PLAN & NOTES

SITE INFORMATION

SITE ID: TXAD0405
SITE NAME: Uptown Plaza
MARKET: DFW
CUSTOMER: CARRIER-A
ADDRESS: 15600 Dallas Pkwy (synthetic)
CITY: Addison
STATE: TX
ZIP: 75001
LATITUDE: 32.9587
LONGITUDE: -96.8295
STRUCTURE TYPE: Rooftop
STRUCTURE HEIGHT (FT): 60
STRUCTURE OWNER: Uptown Plaza Holdings (building owner)
PROJECT TYPE: n41 add + low-band refresh

GENERAL NOTES

CONTRACTOR SHALL VERIFY ALL DIMENSIONS AND EXISTING CONDITIONS BEFORE ORDERING MATERIAL.
ALL WORK PER CARRIER BUILD STANDARDS AND TIA-222-H.
RF CONFIGURATION PER RFDS R3.
MOUNT AND STRUCTURAL ADEQUACY PER MA/SA REPORTS.

MERIDIAN A&E GROUP
(SYNTHETIC SAMPLE)

CLIENT: ERICSSON
CARRIER: CARRIER-A

SITE ID: TXAD0405
SITE: UPTOWN PLAZA
15600 DALLAS PKWY (SYNTHET
ADDISON, TX 75001

STRUCTURE: ROOFTOP
HEIGHT: 60 FT

REV 1 2026-08-30
ISSUED FOR CONSTRUCTION

NOT FOR CONSTRUCTION -
SYNTHETIC POC DATA

SHEET TITLE:
TITLE SHEET & SCOPE OF WORK

SHEET T-1

REDLINE

EQUIPMENT KEY

ScopeIQ - 2026-10-26 - 1 markup(s) - status per ScopeIQ workflow

A1 (E) NNH4-65B-R6 RC 63'

A2R (R) APXVSPP18-C-A20 RC 63'

A2 (P) NNH4-65B-R6 RC 63'


A3 (P) AIR 6419 B41 RC 68'

B1 (E) NNH4-65B-R6 RC 63'

B2R (R) APXVSPP18-C-A20 RC 63'

B3 (P) NNH4-65B-R6 RC 63'

B2 (P) AIR 6419 B41 RC 68'

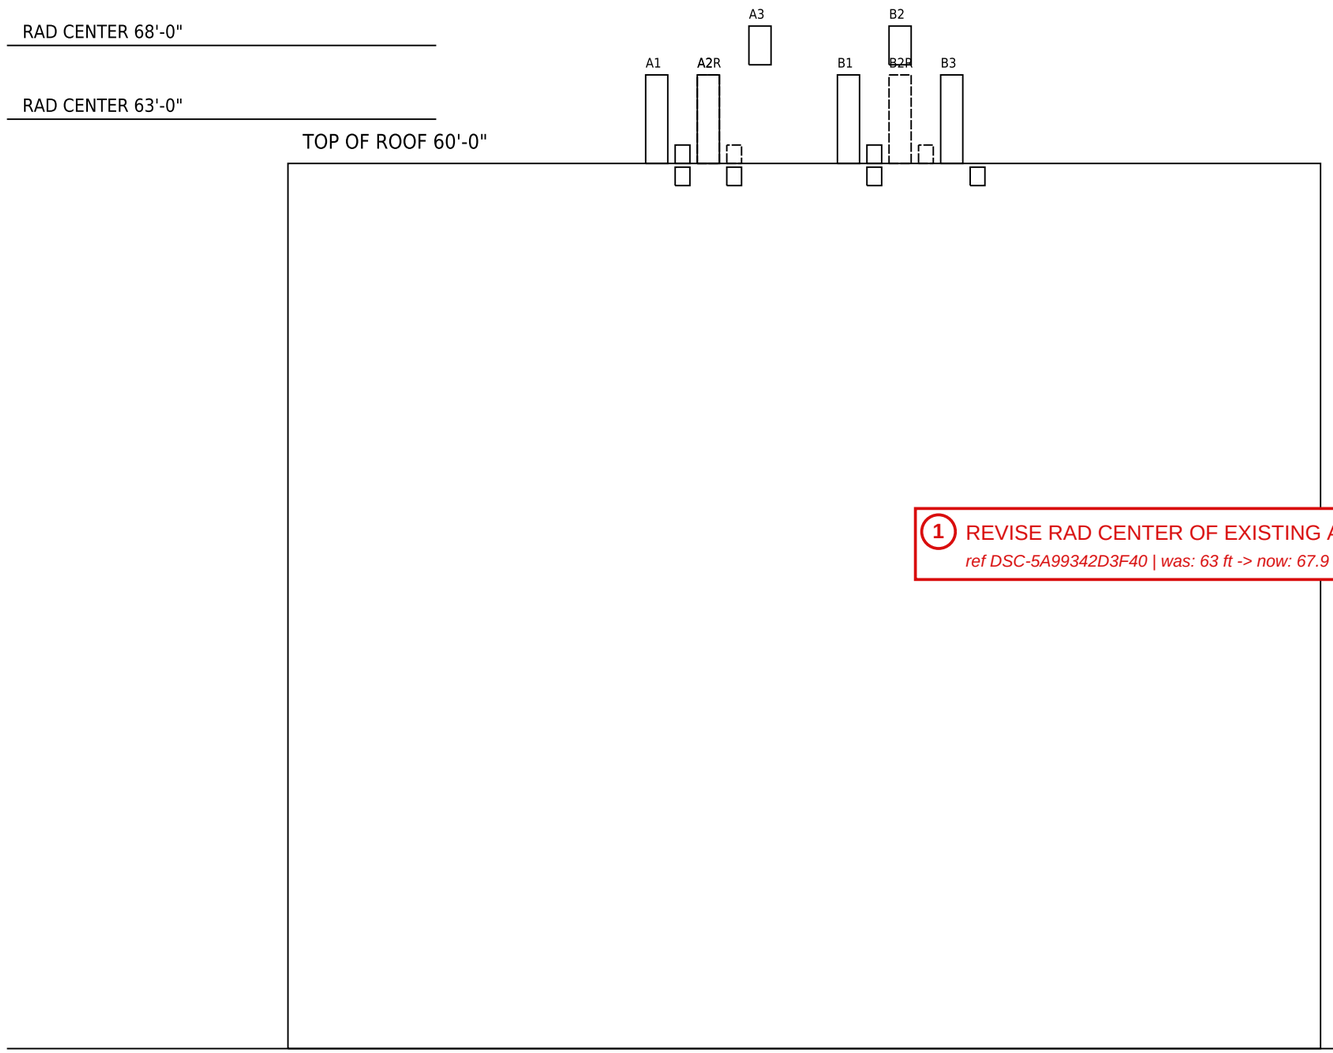

1 REVISE RAD CENTER OF EXISTING ANTENNAS 63 FT -> 67.9 FT (MEASURED).

ref DSC-5A99342D3F40 | was: 63 ft -> now: 67.9 ft

MERIDIAN A&E GROUP

(SYNTHETIC SAMPLE)

CLIENT: ERICSSON

CARRIER: CARRIER-A

SITE ID: TXAD0405

SITE: UPTOWN PLAZA

15600 DALLAS PKWY (SYNTHET

ADDISON, TX 75001

STRUCTURE: ROOFTOP

HEIGHT: 60 FT

REV 1 2026-08-30

ISSUED FOR CONSTRUCTION

NOT FOR CONSTRUCTION -


SYNTHETIC POC DATA

SHEET TITLE:

ELEVATION

SHEET A-2

N

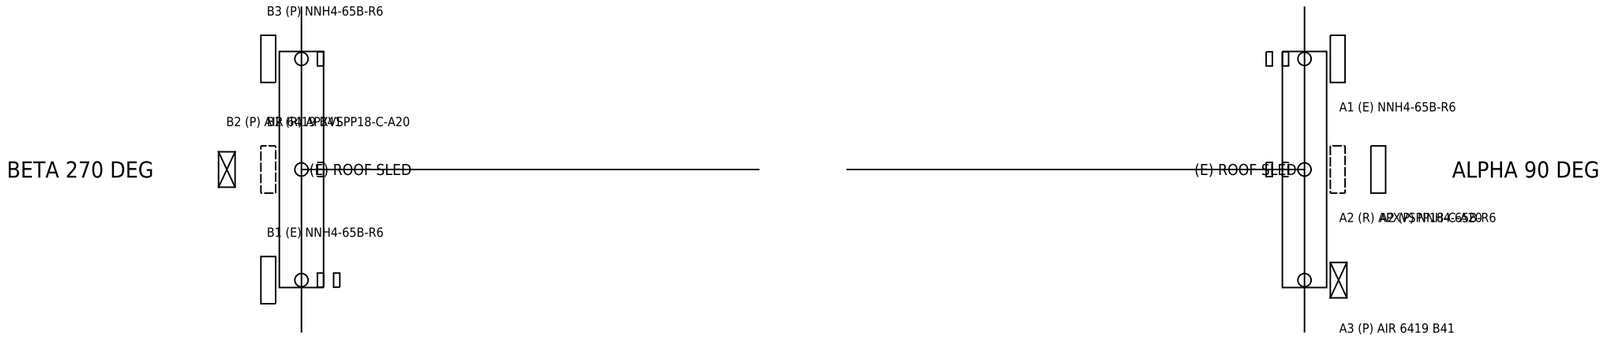

ROOF OUTLINE (E)

(E) EXISTING (P) PROPOSED (R) REMOVE. EQUIPMENT DATA HELD IN BLOCK ATTRIBUTES.

MERIDIAN A&E GROUP

(SYNTHETIC SAMPLE)

CLIENT: ERICSSON

CARRIER: CARRIER-A

SITE ID: TXAD0405

SITE: UPTOWN PLAZA

15600 DALLAS PKWY (SYNTHET

ADDISON, TX 75001

STRUCTURE: ROOFTOP

HEIGHT: 60 FT

REV 1 2026-08-30

ISSUED FOR CONSTRUCTION

NOT FOR CONSTRUCTION -

SYNTHETIC POC DATA

SHEET TITLE:

ANTENNA LAYOUT PLAN

SHEET A-3

ANTENNA & EQUIPMENT SCHEDULE

SECTOR	AZ	POS	STATUS	TYPE	MANUFACTURER	MODEL	RC (FT)	M-TILT	BANDS
ALPHA	90	1	EXISTING	ANTENNA	COMMSCOPE	NNH4-65B-R6	63	1	LB/MB
ALPHA	90	1	EXISTING	RRU	ERICSSON	RADIO 4449 B5 B12	63	-	B5/B12
ALPHA	90	1	EXISTING	RRU	ERICSSON	RADIO 4460 B2 B66	63	-	B2/B66
ALPHA	90	2	REMOVE	ANTENNA	RFS	APXVSPP18-C-A20	63	2	MB
ALPHA	90	2	PROPOSED	ANTENNA	COMMSCOPE	NNH4-65B-R6	63	2	LB/MB
ALPHA	90	2	REMOVE	RRU	ERICSSON	RADIO 2217 B66A	63	-	B66
ALPHA	90	2	PROPOSED	RRU	ERICSSON	RADIO 4480 B71 B85	63	-	B71/B85
ALPHA	90	3	PROPOSED	AAU	ERICSSON	AIR 6419 B41	68	1	n41
BETA	270	1	EXISTING	ANTENNA	COMMSCOPE	NNH4-65B-R6	63	0	LB/MB
BETA	270	1	EXISTING	RRU	ERICSSON	RADIO 4449 B5 B12	63	-	B5/B12
BETA	270	1	EXISTING	RRU	ERICSSON	RADIO 4460 B2 B66	63	-	B2/B66
BETA	270	2	REMOVE	ANTENNA	RFS	APXVSPP18-C-A20	63	1	MB
BETA	270	2	PROPOSED	AAU	ERICSSON	AIR 6419 B41	68	0	n41
BETA	270	2	REMOVE	RRU	ERICSSON	RADIO 2217 B66A	63	-	B66
BETA	270	3	PROPOSED	ANTENNA	COMMSCOPE	NNH4-65B-R6	63	1	LB/MB
BETA	270	3	PROPOSED	RRU	ERICSSON	RADIO 4480 B71 B85	63	-	B71/B85

CABLE SCHEDULE (REQ'D = 1.10 x (VERT + HORIZ))

TRUNK	TYPE	FROM	TO	VERT (FT)	HORIZ (FT)	REQ'D (FT)	SPECIFIED
T1	HYBRID 6x12	BASE OVP / CABINET	TOP OVP	10	45	60.5	100 FT

JUMPER SCHEDULE

JUMPER	ROUTE	LENGTH	QTY
DC JUMPER 8 AWG	TOP OVP TO RRU	15 FT	2
FIBER JUMPER LC-LC	TOP OVP TO RRU	15 FT	2
DC JUMPER 8 AWG	TOP OVP TO AAU	20 FT	2
FIBER JUMPER LC-LC	TOP OVP TO AAU	20 FT	2

MERIDIAN A&E GROUP

(SYNTHETIC SAMPLE)

CLIENT: ERICSSON

CARRIER: CARRIER-A

SITE ID: TXAD0405

SITE: UPTOWN PLAZA

15600 DALLAS PKWY (SYNTHET

ADDISON, TX 75001

STRUCTURE: ROOFTOP

HEIGHT: 60 FT

REV 1 2026-08-30

ISSUED FOR CONSTRUCTION

NOT FOR CONSTRUCTION -


SYNTHETIC POC DATA

SHEET TITLE:

ANTENNA & CABLE SCHEDULE

SHEET A-4

GROUNDING PLAN

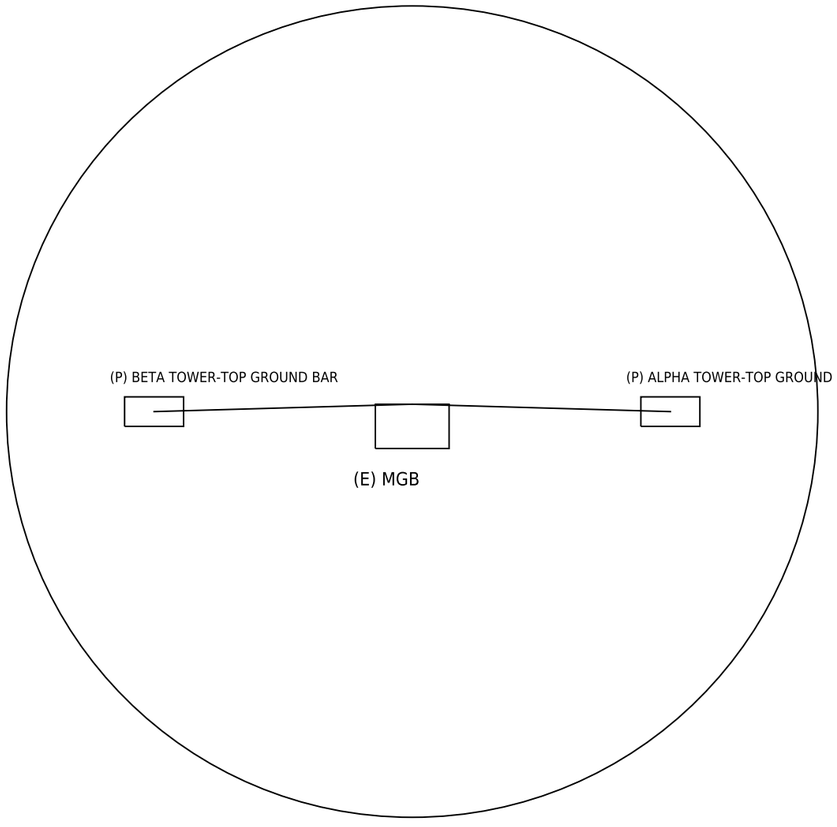

1. BOND EACH NEW RRU, AAU AND ANTENNA TO SECTOR GROUND BAR WITH #6 AWG.

2. GROUND HYBRID TRUNK AT TOP, BOTTOM AND MID-SPAN IF > 200 FT.

3. BOND TOP AND BASE OVP ENCLOSURES WITH #6 AWG.

4. ALL LUGS TWO-HOLE, TINNED, WITH ANTI-OXIDANT.

MERIDIAN A&E GROUP

(SYNTHETIC SAMPLE)

CLIENT: ERICSSON

CARRIER: CARRIER-A

SITE ID: TXAD0405

SITE: UPTOWN PLAZA

15600 DALLAS PKWY (SYNTHET

ADDISON, TX 75001

STRUCTURE: ROOFTOP

HEIGHT: 60 FT

REV 1 2026-08-30

ISSUED FOR CONSTRUCTION

NOT FOR CONSTRUCTION -

SYNTHETIC POC DATA

SHEET TITLE:

GROUNDING PLAN & NOTES

SHEET E-1